

OREGON CORNER RESTORATION FORM

Section: 2, 11 Township: 3N Range: 33E
County: Umatilla Date: 4/11/2012

Corner Designation: 3N33E19

Quarter corner common to Sections 2, 11, T3NR33E.

_____	Condition Report Only
_____ X _____	Not Found
_____ X _____	Remonumented
_____ _____	Unrecorded
_____ X _____	Surveyed In
_____ X _____	Referenced Out


Previous Renewals / Surveys, etc.

Originally surveyed by Chaplin in 1864. He set a post in a mound of earth, with charred stake and pits.

Monuments and Accessories Found: (Condition and Source):

None.


Diagram

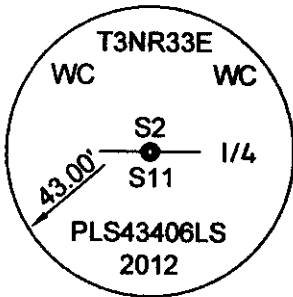

NAD 83/91
OREGON STATE PLANE NORTH
INTERNATIONAL FEET

N769028.32
E8673601.65

Sketch

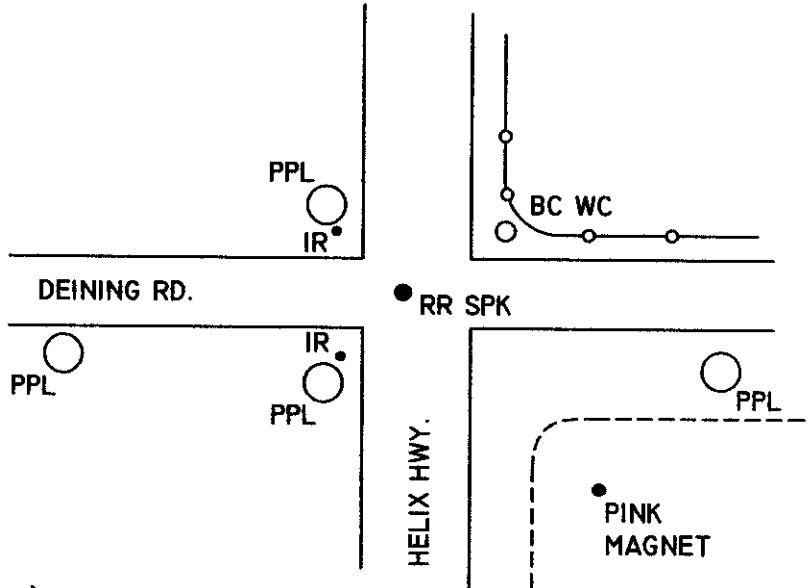

Monument(s) Set (Procedures and Description):

A railroad spike at the corner position, in the South bound lane of the Helix Hwy. at the intersection with the centerline of Deining Rd.

The corner location was reestablished by single proportionate method between neighboring corners to the East and West.

References Set:

- A 5/8" x 30" iron rebar w/ RPC #43406 lies N 23° 40' W, 46.39', at a power pole.
- A 1 1/8" galvanized iron pipe with 2 1/2" brass cap Witness Corner lies N 45° 50' E, 43.01', at the surface.
- A pink "Deep One" magnet by Berntsen lies S 48° 50' E, 58.29', 1.6' deep.
- A 5/8" x 30" iron rebar w/ RPC #43406 lies S 24° 10' W, 41.39', at a power pole.

Location and Comments:

The corner is located in the South bound lane of the Helix Hwy. at the intersection with Deining Rd.

Compass Declination

17° E

Surveyors Seal

REGISTERED
PROFESSIONAL
LAND SURVEYOR

Robert D. English
OREGON
JANUARY 11, 2005
ROBERT DOUGLAS ENGLISH
43406LS

RENEWAL DATE: 12/31/13

RECEIVED BY:

Firm / Agency

Date: 7/10/2012
Rec'd By: S. Rep
No. 12-094-C

Survey One, LLC.
P.O. Box 382
Pendleton, OR 97801
(541) 276-2055