

OREGON CORNER RESTORATION FORM

Section: 6, 7 Township: 3N Range: 33E
County: Umatilla Date: 5/13/2011

Corner Designation: 3N33E03

Quarter corner common to Sections 6, 7, T3NR33E.

| | |
|-------|-----------------------|
| _____ | Condition Report Only |
| X | Not Found |
| X | Remonumented |
| _____ | Unrecorded |
| X | Surveyed In |
| X | Referenced Out |


Previous Renewals / Surveys, etc.

Originally surveyed by Chaplin in 1864. He set a post in a mound of earth.


Monuments and Accessories Found: (Condition and Source):

None.

Diagram

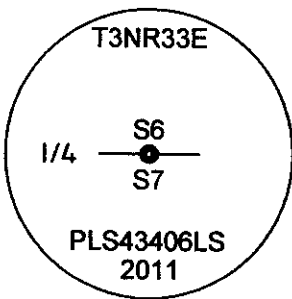

Sketch

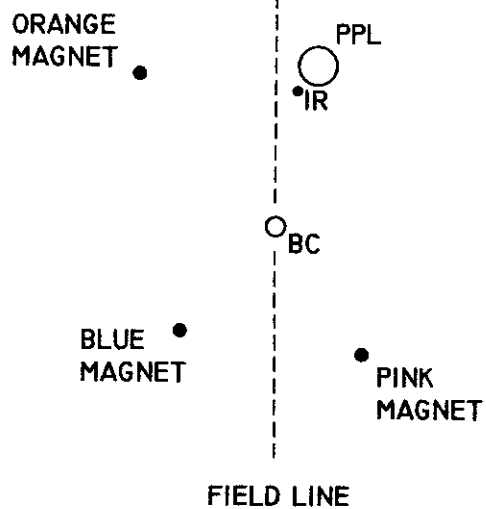

NAD 83/91
OREGON STATE PLANE NORTH
INTERNATIONAL FEET

N768673.56
E8652408.65

Monument(s) Set (Procedures and Description):

A 1 1/8" x 30" galvanized iron pipe with a 2 1/2" brass cap, stamped as shown above, 1.2' below the surface, at the corner set by a combination of single proportionate method and holding a well established, long standing plow berm running North-South through the center of the section.

References Set:

- "Deep One" magnets by Berntsen.
- An orange magnet lies N 42° 20' W, 25.82', 1.8' deep.
- A 5/8" x 30" iron rebar w/ RPC #43406 lies N 8° 40' E, 18.36', at a power pole.
- A pink magnet lies S 34° 20' E, 24.03', 1.8' deep.
- A blue magnet lies S 41° 50' W, 24.32', 1.6' deep.

Location and Comments:

The corner is 1 mile West of the intersection of Anderson Rd. and Myrick Rd.

Compass Declination

17° E

Surveyors Seal

REGISTERED
PROFESSIONAL
LAND SURVEYOR

Robert D. English
OREGON
JANUARY 11, 2005
ROBERT DOUGLAS ENGLISH
43406LS

RENEWAL DATE: 12/31/13

RECEIVED BY:

Firm / Agency

Date: 7/10/2012
Rec'd By: [Signature]
No. 12-094-C

Survey One, LLC.
P.O. Box 382
Pendleton, OR 97801
(541) 276-2055