

OREGON CORNER RESTORATION FORM

Section: 5, 6, 7, 8
County: Umatilla

Township: 3N
Date: 5/13/2011

Range: 33E

Corner Designation: 3N33E05

Section corner common to Sections 5, 6, 7, 8, T3NR33E.

_____	Condition Report Only
X	Not Found
X	Remonumented
_____	Unrecorded
X	Surveyed In
X	Referenced Out


Previous Renewals / Surveys, etc.

Originally surveyed by Chaplin in 1864. He set a post in a mound of earth.


Monuments and Accessories Found: (Condition and Source):

None.

Diagram

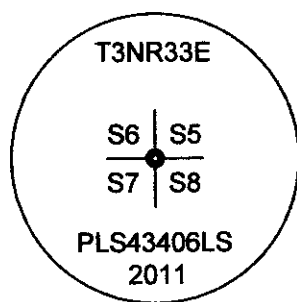

Sketch

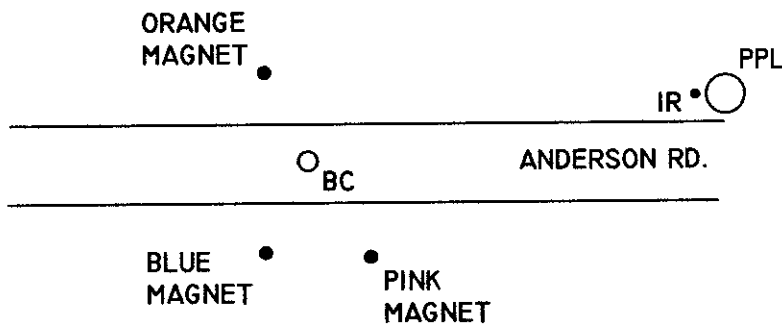

NAD 83/91
OREGON STATE PLANE NORTH
INTERNATIONAL FEET

N768703.48
E8655057.18

Monument(s) Set (Procedures and Description):

A 1 1/8" x 30" galvanized iron pipe with a 2 1/2" brass cap 1.1' below the surface, stamped as shown above. The corner location was reestablished using a combination of single proportionate method for Easting and holding the centerline of Anderson Rd. for Northing, as per Umatilla County Road Note calls to following the section line.

References Set:

- "Deep One" magnets by Berntsen.
- An orange magnet lies N 25° 40' W, 26.01', 1.5' deep.
- A 5/8" x 30" iron rebar w/RPC #43406 lies N 85° 10' E, 128.67', at a power pole.
- A pink magnet lies S 33° E, 28.63', 1.6' deep.
- A blue magnet lies S 25° 10' W, 25.11', 1.6' deep.

Location and Comments:

The corner is 1/2 mile West of the intersection of Anderson Rd. and Myrick Rd.

Compass Declination

17° E

Surveyors Seal

REGISTERED
PROFESSIONAL
LAND SURVEYOR

Robert D. English
OREGON
JANUARY 11, 2005
ROBERT DOUGLAS ENGLISH
43406LS

RENEWAL DATE: 12/31/13

RECEIVED BY:

Date: 7/10/2012
Rec'd By: [Signature]
No. 12-041-1

Firm / Agency

Survey One, LLC.
P.O. Box 382
Pendleton, OR 97801
(541) 276-2055