

**OREGON CORNER RESTORATION FORM**

Section 5 Township 3N  
County Umatilla Date: 03/15/11

Range 33E

Corner Designation: 3N33E7


- CONDITION REPORT ONLY
- NOT FOUND
- REMONUMENTED
- UNRECORDED
- SURVEYED IN
- REFERENCED OUT


**Previous Renewals / Surveys, etc.**

ORIGINALLY SURVEYED BY CHAPLIN IN 1864. HE SET A POST IN A MOUND OF EARTH.  
KRUMBEIN USED THE ROAD INTERSECTION AS A POINT OF REFERENCE IN 1981, IN SURVEY S-153-B.  
KRUMBEIN SET A 2 1/2" BRASS CAP IN 1985 AT THE LOCATION OF THE 1981 SURVEY.


**Monuments and Accessories Found: (Condition and Source)**

FOUND A 2.5" B.C. STAMPED AS SHOWN BELOW, 7" BELOW SURFACE OF GRAVEL ROAD.

**Diagram**

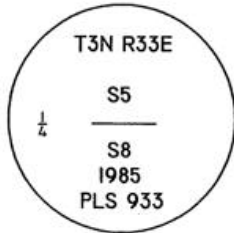

**Sketch**

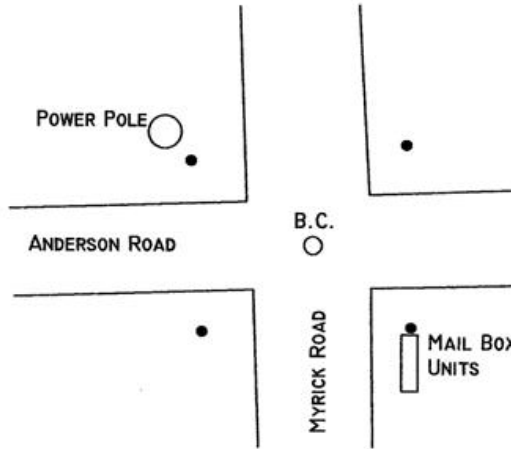

NAD 83/91  
OREGON STATE PLANE NORTH  
INTERNATIONAL FEET

N768734.01  
E8657715.35

**Monument (s) Set (Procedures and Description)**

NONE.

**References Set:** "Deep One" magnets by Berntsen.

- A SILVER MAGNET, 15" DEEP, LIES N 42°20' E, 44.95'.
- A 5/8" x 30" IRON REBAR W/RPC #43406, AT A MAILBOX, LIES S 35°50' E, 28.64'.
- A BLUE MAGNET, 15" DEEP, LIES S 42°10' W, 36.90'.
- A 5/8" x 30" IRON REBAR W/RPC #43406, AT A POWER POLE, LIES N 47°20' W, 32.71'.

**Location and Comments**

THE CORNER IS IN THE INTERSECTION OF  
ANDERSON ROAD AND MYRICK ROAD.

**Compass Declination**

17° E

**Surveyors Seal**

REGISTERED  
PROFESSIONAL  
LAND SURVEYOR

*Robert D. English*  
OREGON  
JANUARY 11, 2005  
ROBERT DOUGLAS ENGLISH  
43406LS

**RECEIVED BY:**

Date: \_\_\_\_\_  
Rec'd By: \_\_\_\_\_  
No. \_\_\_\_\_

**Firm / Agency**

Survey One, LLC.  
P.O. Box 382  
Pendleton, OR 97801  
(541) 276-2055

RENEWAL DATE: 12/31/11