

OREGON CORNER RESTORATION FORM

Section: 4, 5, 8, 9
County: Umatilla

Township: 3N
Date: 2/18/2011

Range: 33E

Corner Designation: 3N33E09 (Amended 3/27/2012)

Section corner common to Sections 4, 5, 8, 9, T3NR33E.

_____	Condition Report Only
X	Not Found
X	Remonumented
_____	Unrecorded
X	Surveyed In
X	Referenced Out


Previous Renewals / Surveys, etc.

Originally surveyed by Chaplin in 1864. He set a post.
Krumbein accepted the intersection of a fence line and field line in Survey S-153-B.


Monuments and Accessories Found: (Condition and Source):

None.

Diagram

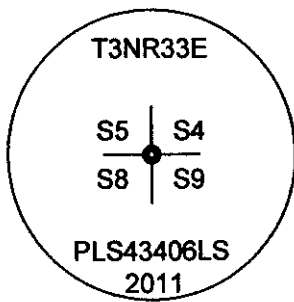

Sketch

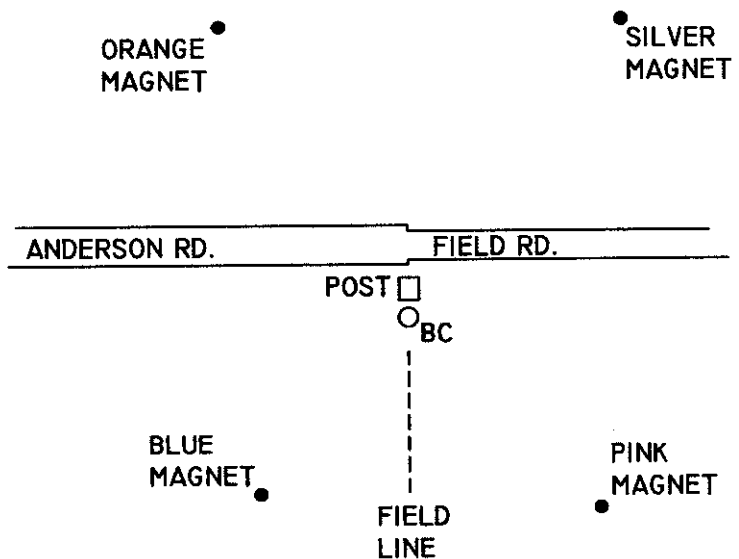

NAD 83/91
OREGON STATE PLANE NORTH
INTERNATIONAL FEET

N768763.96
E8660366.38

Monument(s) Set (Procedures and Description):

A 1 1/8" x 30" galvanized iron pipe with a 2 1/2" brass cap, set at South edge of decaying railroad tie post held by Krumbein in Survey S-153-B, stamped as shown above, 6" below the surface.

References Set:

- "Deep One" magnets by Berntsen.
- An orange magnet lies N 33° 20' W, 36.47', 1.5' deep.
- A silver magnet lies N 36° 20' E, 37.57', 1.6' deep.
- A pink magnet lies S 44° 20' E, 27.64', 1.5' deep.
- A blue magnet lies S 40° W, 23.62', 1.5' deep.

Location and Comments:

The corner is located 1/2 mile East of the intersection of Anderson Rd. and Myrick Rd.

Compass Declination

17° E

Surveyors Seal

REGISTERED
PROFESSIONAL
LAND SURVEYOR

Robert D. English
OREGON
JANUARY 11, 2005
ROBERT DOUGLAS ENGLISH
43406LS

RENEWAL DATE: 12/31/13

RECEIVED BY:

Date: 2/10/2012
Rec'd By: [Signature]
No. 12-094-C

Firm / Agency

Survey One, LLC.
P.O. Box 382
Pendleton, OR 97801
(541) 276-2055