

OREGON CORNER RESTORATION FORM

Section: 9, 10 Township: 3N Range: 33E
County: Umatilla Date: 8/16/2011

Corner Designation: 3N33G13

Quarter corner common to Sections 9, 10, T3NR33E.

	Condition Report Only
X	Not Found
X	Remonumented
	Unrecorded
X	Surveyed In
X	Referenced Out


Previous Renewals / Surveys, etc.

Originally surveyed by Chaplin in 1846. He set a post in a mound of earth.
In 1974 Krumbein found a railroad spike in Survey I-170-A.


Monuments and Accessories Found: (Condition and Source):

None.

Diagram

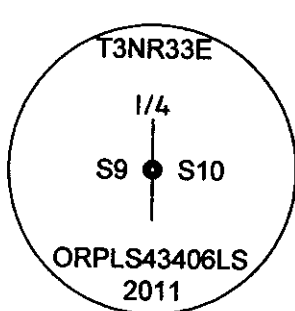

Sketch

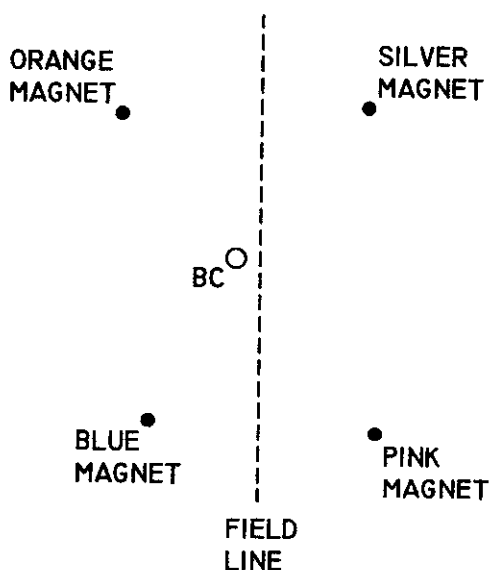

NAD 83/91
OREGON STATE PLANE NORTH
INTERNATIONAL FEET

N766206.33
E8665745.20

Monument(s) Set (Procedures and Description):

A 1 1/8" x 30" galvanized iron pipe with a 2 1/2" brass cap, stamped as shown above, 1.3' below the surface.
The corner location was reestablished by single proportionate method between neighboring corners North and South.

References Set:

"Deep One" magnets by Berntsen.
An orange magnet lies N 37° 50' W, 23.89', 1.6' deep.
A silver magnet lies N 42° E, 26.11', 1.5' deep.
A pink magnet lies S 37° 45' E, 28.66', 1.4' deep.
A blue magnet lies S 28° 45' W, 23.79', 1.6' deep.

Location and Comments:

The corner is located 1 1/2 miles South of the intersection of Midway Rd. and Molstrom Rd.

Compass Declination

17° E

Surveyors Seal

REGISTERED
PROFESSIONAL
LAND SURVEYOR

Robert D. English
OREGON
JANUARY 11, 2005
ROBERT DOUGLAS ENGLISH
43406LS

RENEWAL DATE: 12/31/13

RECEIVED BY:

Date: 7/10/2012
Rec'd By: [Signature]
No. 12-094-C

Firm / Agency

Survey One, LLC.
P.O. Box 382
Pendleton, OR 97801
(541) 276-2055