

OREGON CORNER RESTORATION FORM

Section 7 Township 3N
County Umatilla Date: 03/14/11

Range 33E

Corner Designation: 3N33J1

Corner common to section 12,13, T3NR32E, and section 7,18, T3NR33E.

- Condition Report Only
- Not Found
- Remonumented
- Unrecorded
- Surveyed In
- Referenced Out


Previous Renewals / Surveys, etc.

Originally Surveyed by Thompson in 1864. He set a post in a mound of earth. Moody set a post in a mound of earth in 1871.

Monuments and Accessories Found: (Condition and Source)

None. Road intersection and Westerly fieldline.


Diagram

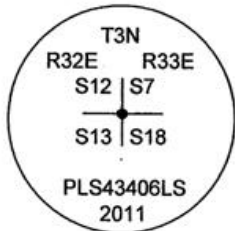

NAD 83/91
OREGON STATE PLANE NORTH
INTERNATIONAL FEET

N763308.41
E8649989.97

Sketch

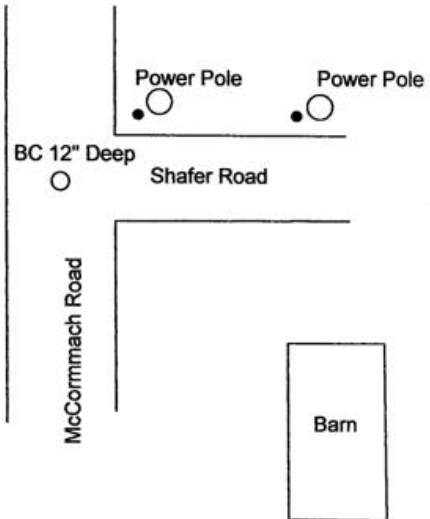

Monument (s) Set (Procedures and Description)

A 1 1/8" X 30" galvanized iron pipe with a 2 1/2" brass cap stamped as shown above. 12" below the surface, using a combination of single proportionate method and road intersection/field line intersection, as best evidence of the original corner position.

References Set: "Deep One" magnets by Berntsen.

- A 5/8" x 30" Iron rebar w/rpc #43406 lies N 41°20' E, 30.22'.
- A 5/8" x 30" iron rebar w/rpc #43406, lies N 80°40' E, 81.89'.
- A Blue magnet, 20" deep, lies S 57°10' W, 27.63'.
- An Orange magnet, 20" deep, lies N 46°30' W, 34.80'.

Location and Comments

The corner is in the intersection of Shafer Road and McCormach Road.

Compass Declination

17° E

Surveyors Seal

REGISTERED
PROFESSIONAL
LAND SURVEYOR

Robert D. English
OREGON
JANUARY II, 2005
ROBERT DOUGLAS ENGLISH
43406LS

RECEIVED BY:

Date: _____
Rec'd By: _____
No. _____

Firm / Agency

Survey One, LLC.
P.O. Box 382
Pendleton, OR 97801
(541) 276-2055

RENEWAL DATE: 12/31/11