

OREGON CORNER RESTORATION FORM

Section 9 Township 3N
County Umatilla Date: 3/11/11

Range 33E

Corner Designation: 3N33J13

Corner common to sections 9,10,15 and 16, T3NR33E.

- Condition Report Only
- Not Found
- Remonumented
- Unrecorded
- Surveyed In
- Referenced Out


Previous Renewals / Surveys, etc.

Originally Surveyed by Chaplin in 1864. He set a post in a mound of earth.
J.R. Gray set a RR spike in 1954, as per survey Q-526-B.
Krumbein found a RR spike in 1981, as per survey S-153-B.


Monuments and Accessories Found: (Condition and Source)

A 2.5" B.C. , 8" below surface.

Diagram

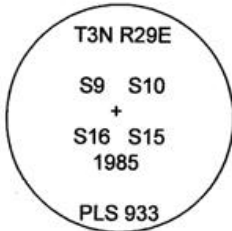

Sketch

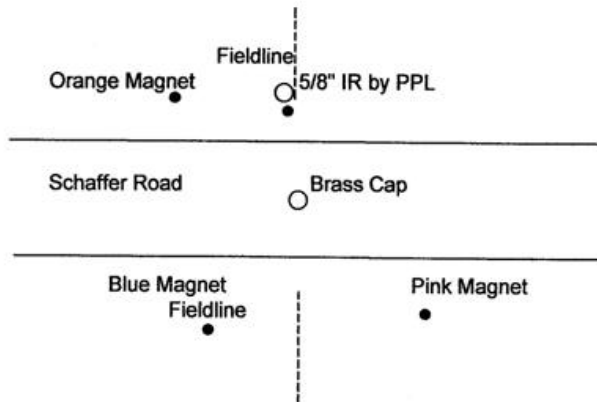

NAD 83/91
OREGON STATE PLANE NORTH
INTERNATIONAL FEET

N763564.21
E8665806.21

Monument (s) Set (Procedures and Description)

None.

References Set: "Deep One" magnets by Berntsen.

- A 5/8" Iron rebar w/rpc #43460 at a power pole, lies N 0° 40' W, 16.27'.
- A Pink Magnet, 19" deep, lies S 26° E, 32.50'.
- A Blue Magnet, 18" deep, lies S 47°20' W, 33.84'.
- An Orange Magnet, 16" deep, lies N 46°20' W, 27.72'.

Location and Comments

The corner is located 1.5 miles West from the intersection of Schaffer Rd. and Helix Hwy. in the middle of the road.

Compass Declination

17° E

Surveyors Seal

REGISTERED
PROFESSIONAL
LAND SURVEYOR

Robert D. English
OREGON
JANUARY II, 2005
ROBERT DOUGLAS ENGLISH
43406LS

RECEIVED BY:

Date: _____
Rec'd By: _____
No. _____

Firm / Agency

Survey One, LLC.
P.O. Box 382
Pendleton, OR 97801
(541) 276-2055

RENEWAL DATE: 12/31/11