

**OREGON CORNER RESTORATION FORM**

Section 10 Township 3N  
County Umatilla Date: 03/15/11

Range 33E

Corner Designation: 3N33J17

Corner common to sections 10,11,14 and 15, T3NR33E.

- Condition Report Only
- Not Found
- Remonumented
- Unrecorded
- Surveyed In
- Referenced Out


**Previous Renewals / Surveys, etc.**

Originally Surveyed by Chaplin in 1864. He set a post in a mound of earth. Wells set a 2 1/2" brass cap in 1988, in survey 88-17-B.


**Monuments and Accessories Found: (Condition and Source)**

A 2.5" B.C.

**Diagram**

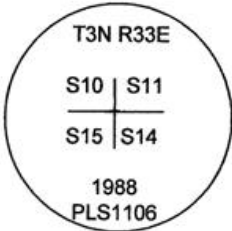

**Sketch**

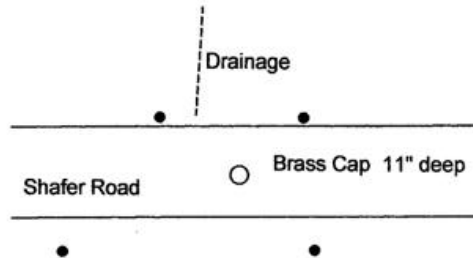

NAD 83/91  
OREGON STATE PLANE NORTH  
INTERNATIONAL FEET

N763669.31  
E8671083.04

**Monument (s) Set (Procedures and Description)**

None.

**References Set:**

- A 5/8" x 30" iron rebar w/rpc #43406, lies N 37°50' E, 31.53'.
- A 5/8" x 30" iron rebar w/rpc #43406, lies S 41° E, 23.38'.
- A 5/8" x 30" iron rebar w/rpc #43406, lies S 67°10' W, 48.01'.
- A 5/8" x 30" iron rebar w/rpc #43406, lies N 46°50' W, 55.51'.

**Location and Comments**

The corner 1.5 miles West from the intersection of Helix Hwy. and Shafer Road.

**Compass Declination**

17° E

**Surveyors Seal**

REGISTERED  
PROFESSIONAL  
LAND SURVEYOR

*Robert D. English*  
 OREGON  
 JANUARY 11, 2005  
 ROBERT DOUGLAS ENGLISH  
 43406LS

RENEWAL DATE: 12/31/11

**RECEIVED BY:**

Date: \_\_\_\_\_  
 Rec'd By: \_\_\_\_\_  
 No. \_\_\_\_\_

**Firm / Agency**

Survey One, LLC.  
 P.O. Box 382  
 Pendleton, OR 97801  
 (541) 276-2055