

OREGON CORNER RESTORATION FORM

Section: 7, 8, 17, 18 Township: 3N Range: 33E
County: Umatilla Date: 5/16/2011

Corner Designation: 3N33J05

Section corner common to Sections 7, 8, 17, 18, T3NR33E.

_____	Condition Report Only
<u> X </u>	Not Found
<u> X </u>	Remonumented
_____	Unrecorded
<u> X </u>	Surveyed In
<u> X </u>	Referenced Out


Previous Renewals / Surveys, etc.

Originally surveyed by Chaplin in 1864. He set a post in a mound of earth.


Monuments and Accessories Found: (Condition and Source):

None.

Diagram

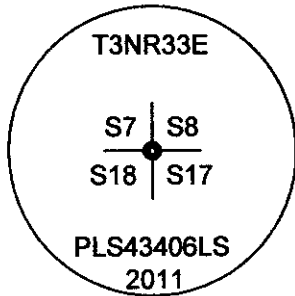

Sketch

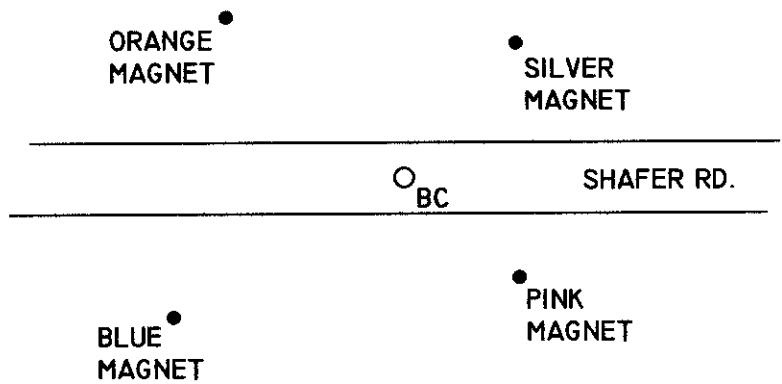

NAD 83/91
OREGON STATE PLANE NORTH
INTERNATIONAL FEET

N763419.92
E8655155.61

Monument(s) Set (Procedures and Description):

A 1 1/8" x 30" galvanized iron pipe with a 2 1/2" brass cap, stamped as shown above, 1' below the surface of the road. Corner location was reestablished using single proportionate method between corners 1/2 mile to East and West for Easting and by holding the centerline of Shafer Road, per Umatilla County Road Notes, for Northing. These were the best evidence of original location.

References Set:

- "Deep One" magnets by Berntsen.
- An orange magnet lies N 48° 10' W, 31.86', 1.3' deep.
- A silver magnet lies N 40° E, 25.53', 1.3' deep.
- A pink magnet lies S 49° 10' E, 27.25', 1.2' deep.
- A blue magnet lies S 59° 10' W, 37.73', 1.2' deep.

Location and Comments:

The corner is located 1/2 mile West of the intersection of Shafer Rd. and Myrick Rd.

Compass Declination

17° E

Surveyors Seal

REGISTERED
PROFESSIONAL
LAND SURVEYOR

Robert D. English
 OREGON
 JANUARY 11, 2005
 ROBERT DOUGLAS ENGLISH
 43406LS

RECEIVED BY:

Date: 7/10/2012
 Rec'd By: A. Oles
 No. 12-094-C

Firm / Agency

Survey One, LLC.
 P.O. Box 382
 Pendleton, OR 97801
 (541) 276-2055

RENEWAL DATE: 12/31/13