

OREGON CORNER RESTORATION FORM

Section 16,21 Township 3N
County Umatilla Date: 03/22/11

Range 33E

Corner Designation: 3N33N11

Corner common to section 16 and 21 T3NR33E.

_____ Condition Report Only
 Not Found
 Remonumented
_____ Unrecorded
 Surveyed In
 Referenced Out

Previous Renewals / Surveys, etc.



Originally Surveyed by Chaplin in 1864. He set a stone.

Monuments and Accessories Found: (Condition and Source)

None.

Sketch

Diagram

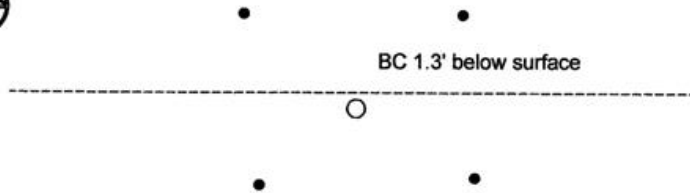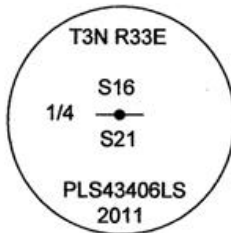

NAD 83/91
OREGON STATE PLANE NORTH
INTERNATIONAL FEET

N758263.97
E8663280.51

Monument (s) Set (Procedures and Description)

A 1 1/2" x 30" galvanized iron pipe with a 2 1/2" Brass cap, stamped as shown above, reestablished by single proportionate method between found corners.

References Set: "Deep One" magnets by Berntsen.
A Silver magnet, 19" deep, lies N 47°20' E, 21.27'.
A Pink magnet, 20" deep, lies S 39°10' E, 20.14'.
A Blue magnet, 20" deep, lies S 41°40' W, 28.90'.
An Orange magnet, 19" deep, lies N 41°20' W, 24.69'.

Location and Comments

The corner is 1 mile West of the intersection of Myrick Road and Fulton Road.

Compass Declination

17° E

Surveyors Seal

REGISTERED
PROFESSIONAL
LAND SURVEYOR

Robert D. English

OREGON
JANUARY II, 2005
ROBERT DOUGLAS ENGLISH
43406LS

RECEIVED BY:

Date: _____
Rec'd By: _____
No. _____

Firm / Agency

Survey One, LLC.
P.O. Box 382
Pendleton, OR 97801
(541) 276-2055

RENEWAL DATE: 12/31/11