

OREGON CORNER RESTORATION FORM

Section: 15, 16, 21, 22
County: Umatilla

Township: 3N
Date: 3/22/2011

Range: 33E

Corner Designation: 3N33N13 (Amended 3/14/2012)

Section corner common to Sections 15, 16, 21, 22 T3NR33E.

	Condition Report Only
X	Not Found
X	Remonumented
	Unrecorded
X	Surveyed In
X	Referenced Out


Previous Renewals / Surveys, etc.

Originally surveyed by Chaplin in 1864. He set a post in a mound of earth.


Monuments and Accessories Found: (Condition and Source):

None.

Diagram

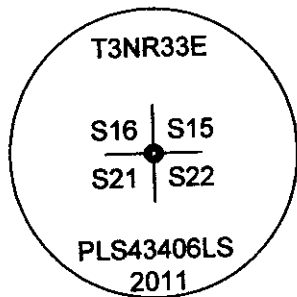

Sketch

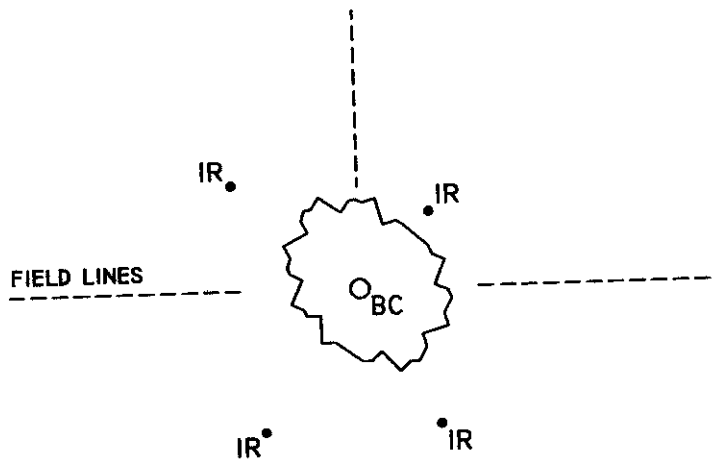

NAD 83/91
OREGON STATE PLANE NORTH
INTERNATIONAL FEET

N758319.15
E8665919.67

Monument(s) Set (Procedures and Description):

A 1 1/8" x 30" galvanized iron pipe with a 2 1/2" brass cap, stamped as shown above, in a mound of stones at an intersection of field lines. This location has obviously been held as the corner for a long time and I accept it as best evidence.

References Set:

- "Deep One" magnets by Bernsten.
- An orange magnet lies N 50° 20' W, 25.97', 1.5' deep.
- A silver magnet lies N 43° 20' E, 15.05', 1.6' deep.
- A pink magnet lies S 28° 50' E, 27.75', 1.6' deep.
- A blue magnet lies S 35° 30' W, 30.35', 1.6' deep.

Location and Comments:

The corner is located 1 1/2 miles East of the intersection of Fulton Rd. and Myrick Rd.

Compass Declination
17° E

Surveyors Seal

REGISTERED
PROFESSIONAL
LAND SURVEYOR

Robert Douglas English
OREGON
JANUARY 11, 2005
ROBERT DOUGLAS ENGLISH
43406LS

RENEWAL DATE: 12/31/13

RECEIVED BY:

Date: 7/10/2012
Rec'd By: S. Greg
No. 12-094-C

Firm / Agency

Survey One, LLC.
P.O. Box 382
Pendleton, OR 97801
(541) 276-2055