

**OREGON CORNER RESTORATION FORM**

Section: 13, 14, 23, 24      Township: 3N      Range: 33E  
County: Umatilla      Date: 2/9/2012

Corner Designation: 3N33N21

Section corner common to Sections 13, 14, 23, 24, T3NR33E.

_____	Condition Report Only
X	Not Found
X	Remonumented
_____	Unrecorded
X	Surveyed In
X	Referenced Out


**Previous Renewals / Surveys, etc.**

Originally surveyed by Chaplin in 1864. He set a 24" x 5" x 5" stone.  
In 1887 Currin and Noland found a marked 10" x 10" x 10" stone.  
In 1899 J. Kimbrell found the corner in Private Survey No. 113, as recorded in Book 1, pg. 420.


**Monuments and Accessories Found: (Condition and Source):**

None.

Diagram

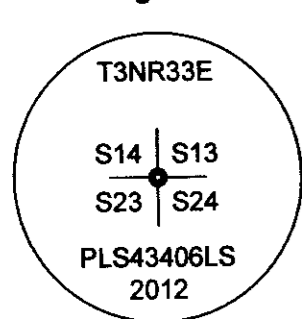

Sketch

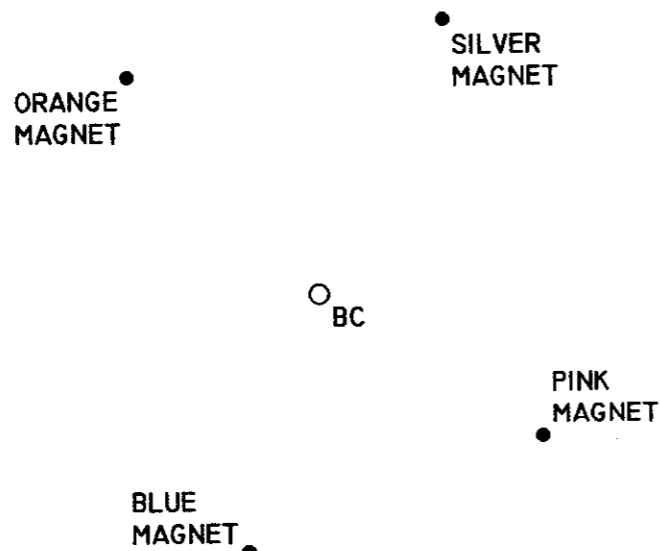

NAD 83/91  
OREGON STATE PLANE NORTH  
INTERNATIONAL FEET

N758523.38  
E8676489.58

**Monument(s) Set (Procedures and Description):**

A 1 1/8" x 30" galvanized iron pipe with 2 1/2" brass cap, stamped as shown above, 1.4' below the surface.  
The corner location was reestablished by double proportionate method. All evidence has been farmed out, as the corner lies in an active, leveled wheat field.

**References Set:**

"Deep One" magnets by Berntsen.  
An orange magnet lies N 39° 50' W, 37.40', 1.6' deep.  
A silver magnet lies N 25° 45' E, 39.28', 1.6' deep.  
A pink magnet lies S 55° 50' E, 34.56', 1.6' deep.  
A blue magnet lies S 17° W, 35.06', 1.8' deep.

**Location and Comments:**

The corner is located 1/2 mile, M/L,  
East-Northeast of the intersection of Adams  
Rd. and the Helix Hwy.

**Compass Declination**

17° E

**Surveyors Seal**

REGISTERED  
PROFESSIONAL  
LAND SURVEYOR

*Robert D. English*  
OREGON  
JANUARY 11, 2005  
ROBERT DOUGLAS ENGLISH  
43406LS

RENEWAL DATE: 12/31/13

**RECEIVED BY:**

Date: 2/10/2012  
Rec'd By: S. Oles  
No. 12-094-C

**Firm / Agency**

Survey One, LLC.  
P.O. Box 382  
Pendleton, OR 97801  
(541) 276-2055