

**OREGON CORNER RESTORATION FORM**

Section: 13, 24 Township: 3N Range: 33E  
County: Umatilla Date: 3/9/2012

Corner Designation: 3N33N23

Quarter corner common to Sections 13, 24, T3NR33E.

|       |                       |
|-------|-----------------------|
| _____ | Condition Report Only |
| X     | Not Found             |
| X     | Re-monumented         |
| _____ | Unrecorded            |
| X     | Surveyed In           |
| X     | Referenced Out        |


**Previous Renewals / Surveys, etc.**

Originally surveyed by Chaplin in 1864. He set a 26" x 12" x 4" stone.  
In 1871 Moody set a post in a mound of earth.  
In 1887 Currin and Noland set a 22" x 8" x 5" basalt stone in a mound of earth and dug pits to the East and West.


**Monuments and Accessories Found: (Condition and Source):**

None.

Diagram

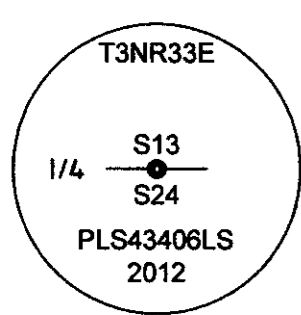

Sketch

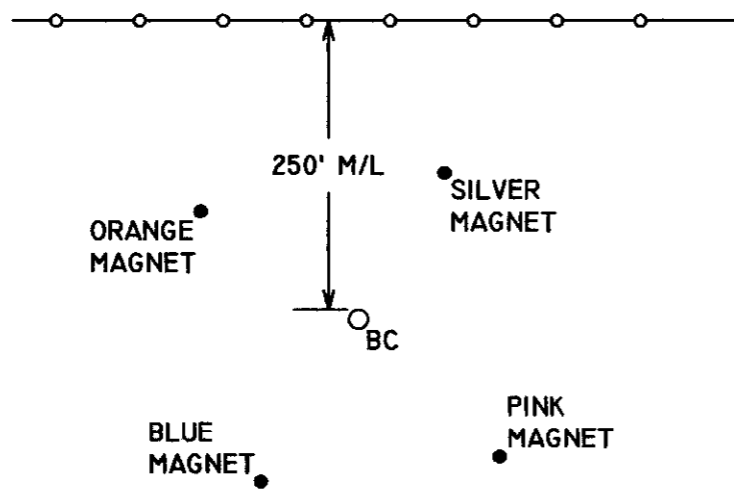

NAD 83/91  
OREGON STATE PLANE NORTH  
INTERNATIONAL FEET

N758606.28  
E8679102.99

**Monument(s) Set (Procedures and Description):**

A 1 1/8" x 30" galvanized iron pipe with 2 1/2" brass cap, stamped as shown above, 1.6' below the surface.  
The corner location was reestablished by single proportionate method between neighboring corners to the East and West, in active wheat field.

**References Set:**

"Deep One" magnets by Berntsen.  
An orange magnet lies N 60° 30' W, 24.62', 1.8' deep.  
A silver magnet lies N 23° 05' E, 23.01', 1.9' deep.  
A pink magnet lies S 47° 05' E, 24.69', 1.7' deep.  
A blue magnet lies S 23° W, 27.23', 1.9' deep.

**Location and Comments:**

The corner is located 1 1/2 miles, M/L,  
Northeast of the intersection of Hwy. 11 and  
the Helix Hwy.

**Compass Declination**

17° E

**Surveyors Seal**

REGISTERED  
PROFESSIONAL  
LAND SURVEYOR

*Robert D. English*  
OREGON  
JANUARY 11, 2005  
ROBERT DOUGLAS ENGLISH  
43406LS

RENEWAL DATE: 12/31/13

**RECEIVED BY:**

Date: 7/10/2012  
Rec'd By: S. Ples  
No. 12-094-C

**Firm / Agency**

Survey One, LLC.  
P.O. Box 382  
Pendleton, OR 97801  
(541) 276-2055