

OREGON CORNER RESTORATION FORM

Section: 18, 19 Township: 3N Range: 33E
County: Umatilla Date: 4/21/2011

Corner Designation: 3N33N03 (Amended 4/3/2012)

Quarter corner common to Sections 18, 19, T3NR33E.

	Condition Report Only
X	Not Found
X	Remonumented
	Unrecorded
X	Surveyed In
X	Referenced Out


Previous Renewals / Surveys, etc.

Originally surveyed by Chaplin in 1864. He set a post in a mound of earth.


Monuments and Accessories Found: (Condition and Source):

None.

Diagram

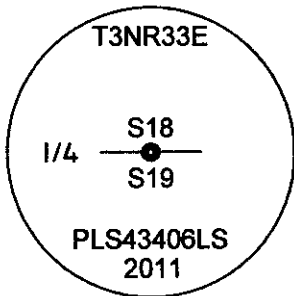

Sketch

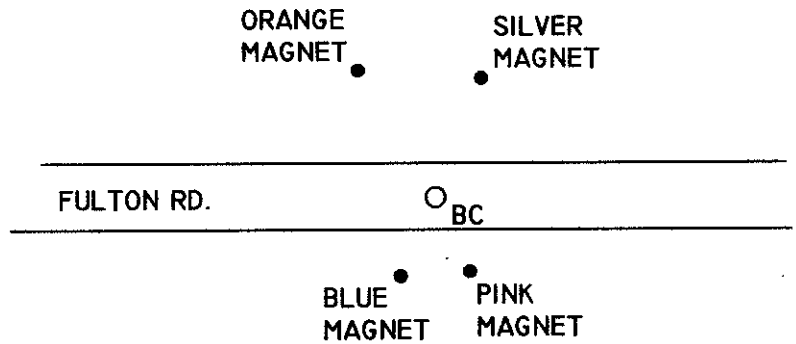

NAD 83/91
OREGON STATE PLANE NORTH
INTERNATIONAL FEET

N758075.27
E8652654.52

Monument(s) Set (Procedures and Description):

A 1 1/8" x 30" galvanized iron pipe with a 2 1/2" brass cap, stamped as shown above, 1.1' below the surface. The corner location was reestablished by holding the centerline of Fulton Rd. for Northing, per Umatilla County Road Notes, and using single proportionate method for Easting, with weight given to a post which lies at the end of a field line to the North of the corner.

References Set:

- "Deep One" magnets by Bermtsen.
- An orange magnet lies N 41° 30' W, 27.72', 1.0' deep.
- A silver magnet lies N 29° 20' E, 27.41'.
- A pink magnet lies S 39° 15' E, 20.95'.
- A blue magnet lies S 42° 25' W, 22.28'.

Location and Comments:

The corner is located 1/2 mile East of the intersection of Fulton Rd. and McCormach Rd.

Compass Declination

17° E

Surveyors Seal

REGISTERED
PROFESSIONAL
LAND SURVEYOR

Robert D. English
OREGON
JANUARY II, 2005
ROBERT DOUGLAS ENGLISH
43406LS

RECEIVED BY:

Date: 7/10/2012
Rec'd By: A. Oles
No. 12-094-C

Firm / Agency

Survey One, LLC.
P.O. Box 382
Pendleton, OR 97801
(541) 276-2055

RENEWAL DATE: 12/31/13