

OREGON CORNER RESTORATION FORM

Section 16,17,20,21 Township 3N
County Umatilla Date: 03/11/11

Range 33E

Corner Designation: 3N33N9

Corner common to sections 16,17,20 and 21, T3NR33E.

- Condition Report Only
- Not Found
- Remonumented
- Unrecorded
- Surveyed In
- Referenced Out


Previous Renewals / Surveys, etc.

Originally Surveyed by Chaplin in 1864. He set a post in a mound of earth. Harris accepted a fence corner in 1956, as per survey 03-154-A. Wells found an old fence corner, and set a 2 3/8" brass cap.


Monuments and Accessories Found: (Condition and Source)

- A 2 1/2" Brass Cap, as stamped below.
- A 5/8" iron rebar w/rpc #1106, lies N 04° E, 26.9'.
- A 5/8" iron rebar w/rpc #1106, lies N 04° E, 53.6'.
- A 5/8" iron rebar w/rpc #1106, lies S 86° E, 16.9'.
- A 5/8" iron rebar w/rpc #1106, lies S 86° E, 40.9'.

Diagram

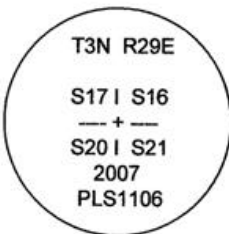

Sketch

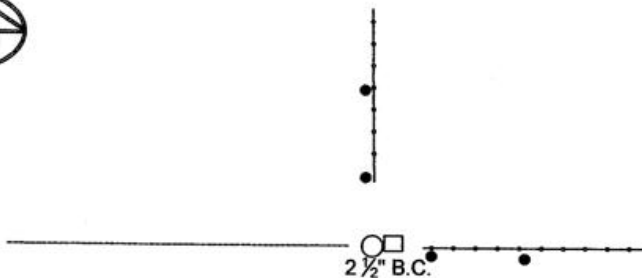

NAD 83/91
OREGON STATE PLANE NORTH
INTERNATIONAL FEET

N758208.15
E8660638.37

Monument (s) Set (Procedures and Description)

None.

References Set:

None.

Location and Comments

Located at a fence corner in the edge of two fields, 0.5 miles East of Myrick Road.

Compass Declination

17° E

Surveyors Seal

REGISTERED
PROFESSIONAL
LAND SURVEYOR

Robert D. English
OREGON
JANUARY 11, 2005
ROBERT DOUGLAS ENGLISH
43406LS

RECEIVED BY:

Date: _____
Rec'd By: _____
No. _____

Firm / Agency

Survey One, LLC.
P.O. Box 382
Pendleton, OR 97801
(541) 276-2055

RENEWAL DATE: 12/31/11