

**OREGON CORNER RESTORATION FORM**

Section: 16, 17, 20, 21 Township: 3N Range: 33E  
County: Umatilla Date: 3/4/2011

Corner Designation: 3N33N09 (Amended 3/9/2012)

Section corner common to Sections 16, 17, 20, 21, T3NR33E.

<input checked="" type="checkbox"/>	Condition Report Only
<input type="checkbox"/>	Not Found
<input type="checkbox"/>	Remonumented
<input type="checkbox"/>	Unrecorded
<input type="checkbox"/>	Surveyed In
<input checked="" type="checkbox"/>	Referenced Out


**Previous Renewals / Surveys, etc.**

Originally surveyed by Chaplin in 1864. He set a post in a mound of earth.  
In 1956 Harris accepted a fence corner in Survey 03-154-A.  
In 2007 Wells accepted a fence corner and set a brass cap in Survey 07-238-C.


**Monuments and Accessories Found: (Condition and Source):**

- A 2 3/8" brass cap.
- A 5/8" iron rebar w/RPC #1106 lies N 04° E, 26.9'.
- A 5/8" iron rebar w/RPC #1106 lies N 04° E, 53.6'.
- A 5/8" iron rebar w/RPC #1106 lies S 86° E, 16.9'.
- A 5/8" iron rebar w/RPC #1106 lies S 86° E, 40.9'.

**Diagram**

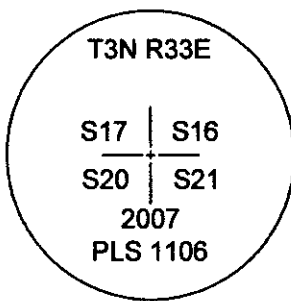

**Sketch**

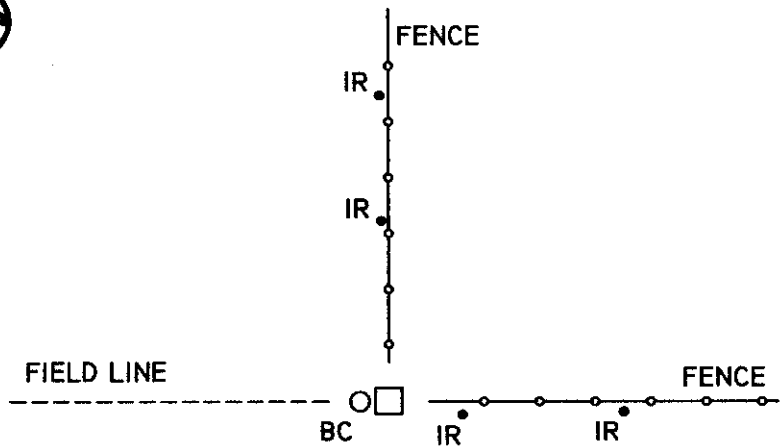

NAD 83/91  
OREGON STATE PLANE NORTH  
INTERNATIONAL FEET

N758207.55  
E8660635.39

**Monument(s) Set (Procedures and Description):**

None.

**References Set:**

None.

**Location and Comments:**

The corner is located 1/2 mile East of the intersection of Fulton Rd. and Myrick Rd. at a fence corner.

**Compass Declination**

17° E

**Surveyors Seal**

REGISTERED  
PROFESSIONAL  
LAND SURVEYOR

*Robert D. English*

OREGON  
JANUARY 11, 2005  
ROBERT DOUGLAS ENGLISH  
43406LS

RENEWAL DATE: 12/31/13

**RECEIVED BY:**

Date: 7/10/2012  
Rec'd By: A. Wells  
No. 12-094-C

**Firm / Agency**

Survey One, LLC.  
P.O. Box 382  
Pendleton, OR 97801  
(541) 276-2055