

**OREGON CORNER RESTORATION FORM**

Section: 21, 22 Township: 3N Range: 33E  
County: Umatilla Date: 3/20/2012

Corner Designation: 3N33P13

Quarter corner common to Sections 21, 22, T3NR33E.

_____	Condition Report Only
<u>  X  </u>	Not Found
<u>  X  </u>	Remonumented
_____	Unrecorded
<u>  X  </u>	Surveyed In
<u>  X  </u>	Referenced Out


**Previous Renewals / Surveys, etc.**

Originally surveyed by Chaplin in 1864. He set a post in a mound of earth, with charred stake and pits. In 1887 Currin and Noland found a mound of stone with a marked 9" x 8" x 7" stone under the mound. In 1882 Coffey found a post in Private Survey No. 8, as recorded in Book 1, pg. 78.


**Monuments and Accessories Found: (Condition and Source):**

None.

**Diagram**

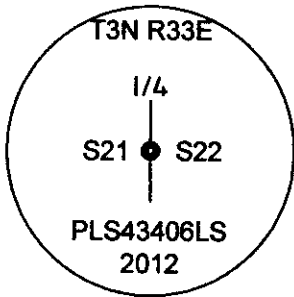

**Sketch**

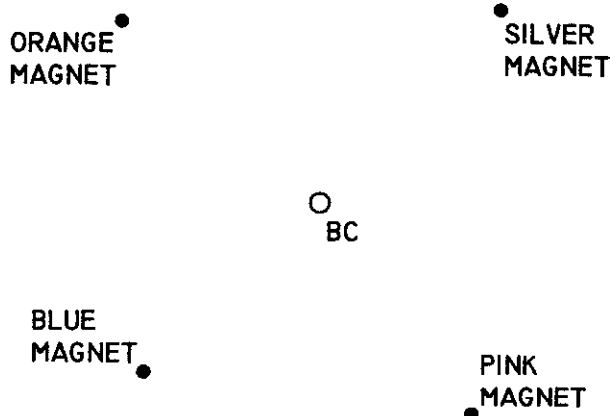

NAD 83/91  
OREGON STATE PLANE NORTH  
INTERNATIONAL FEET

N755670.66  
E8665974.14

**Monument(s) Set (Procedures and Description):**

A 1 1/8" x 30" galvanized iron pipe with 2 1/2" brass cap, stamped as shown above, 1.3' below the surface. The corner location was reestablished by single proportionate method between neighboring corners to the North and South.

**References Set:**

- "Deep One" magnets by Berntsen.
- An orange magnet lies N 47° 20' W, 28.08', 1.8' deep.
- A silver magnet lies N 44° 15' E, 27.69', 1.7' deep.
- A pink magnet lies S 34° 50' E, 27.27', 1.8' deep.
- A blue magnet lies S 46° 30' W, 25.36', 1.6' deep.

**Location and Comments:**

The corner is located 1 1/2 miles South and 1 1/2 miles West of the intersection of Shafer Rd. and the Helix Hwy. Corner falls in a heavily farmed field that is now in CRP, overlooking Wildhorse Creek.

**Compass Declination**

17° E

**Surveyors Seal**

REGISTERED  
PROFESSIONAL  
LAND SURVEYOR

*Robert D. English*  
OREGON  
JANUARY 11, 2005  
ROBERT DOUGLAS ENGLISH  
43406LS

**RECEIVED BY:**

Date: 7/10/2012  
Rec'd By: S. Des  
No. 12-094-C

**Firm / Agency**

Survey One, LLC.  
P.O. Box 382  
Pendleton, OR 97801  
(541) 276-2055

RENEWAL DATE: 12/31/13