

**OREGON CORNER RESTORATION FORM**

Section: 23, 26 Township: 3N Range: 33E  
County: Umatilla Date: 4/19/2012

Corner Designation: 3N33R19 (Amended 5/15/2012)

Quarter corner common to Sections 23, 26, T3NR33E.

_____	Condition Report Only
_____	Not Found
_____	Remonumented
_____	Unrecorded
_____	Surveyed In
<u>  X  </u>	Referenced Out


**Previous Renewals / Surveys, etc.**

Originally surveyed by Chaplin in 1864. He set a post in a mound of earth, with charred stake and pits.  
In 1871 Moody set a post in a mound of earth.  
In 1887 Currin and Noland set a 9" x 8" x 7" basalt stone 6" in the ground, with 1/4 marked on the North face, dug 18" x 18" x 12" pits to the East and West, and raised a mound of earth over the stone.  
In 2012 Roberts set a PK Nail w/ brass washer in LCR R19-12-63C.


**Monuments and Accessories Found: (Condition and Source):**

A PK Nail w/ brass washer, stamped LS2627, in the center line of the Helix Hwy.

Diagram

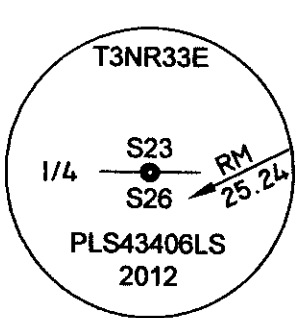

Sketch

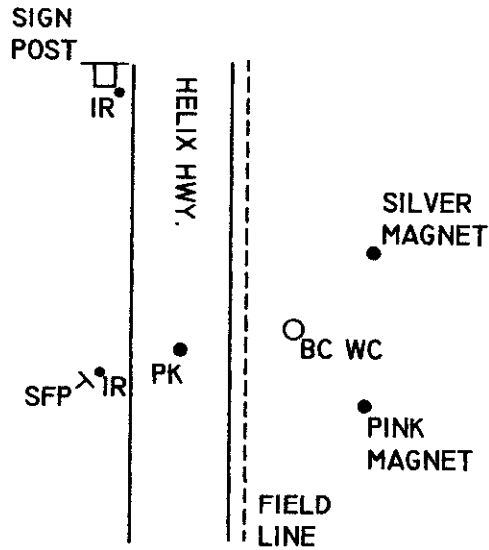

NAD 83/91  
OREGON STATE PLANE NORTH  
INTERNATIONAL FEET  
  
N753147.80  
E8673937.24

**Monument(s) Set (Procedures and Description):**

A 1 1/8" x 30" galvanized iron pipe with 2 1/2" brass cap witness corner, stamped as shown above, 1.6' below the surface lies N 80° 48' 08" E, 25.24'.  
The corner location was reestablished at the intersection of the projection of Tubbs Ranch Rd. and the centerline of the Helix Hwy., per Umatilla County Road Notes.

**References Set:**

"Deep One" magnets by Berntsen.  
A 5/8" x 30" iron rebar w/RPC #43406 lies N 17° 11' 01" W, 68.95', at a sign post.  
A silver magnet lies N 61° 55' E, 51.65', 1.6' deep.  
A pink magnet lies S 70° E, 46.23', 1.8' deep.  
A 5/8" x 30" iron rebar w/RPC #43406 lies S 71° 19' 36" W, 22.56', at a steel fence post.

**Location and Comments:**

The corner is located 350', M/L, North of the intersection of Hwy. 11 and the Helix Hwy., at the centerline of the Helix Hwy.

**Compass Declination**

17° E

**Surveyors Seal**

REGISTERED  
PROFESSIONAL  
LAND SURVEYOR

*Robert D. English*  
OREGON  
JANUARY 11, 2005  
ROBERT DOUGLAS ENGLISH  
43406LS

RENEWAL DATE: 12/31/13

**RECEIVED BY:**

Date: 7/10/2012  
Rec'd By: S. Lopez  
No. 12-094-C

**Firm / Agency**

Survey One, LLC.  
P.O. Box 382  
Pendleton, OR 97801  
(541) 276-2055