

OREGON CORNER RESTORATION FORM

Section 19,30 Township 3N
County Umatilla Date: 3/17/11

Range 33E

Corner Designation: 3N33R3

1/4 Corner common to Sections 19,30 T3NR33E.

- _____ Condition Report Only
- _____ X _____ Not Found
- _____ X _____ Remonumented
- _____ _____ Unrecorded
- _____ X _____ Surveyed In
- _____ X _____ Referenced Out


Previous Renewals / Surveys, etc.

Originally Surveyed by Chaplin in 1864. He set a post in a mound of earth.


Monuments and Accessories Found: (Condition and Source)

None.

Diagram

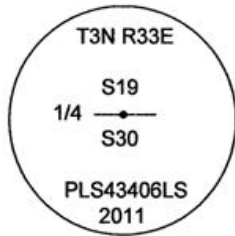

Sketch

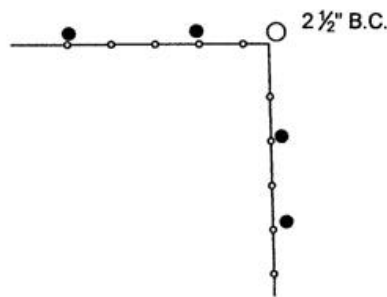

NAD 83/91
OREGON STATE PLANE NORTH
INTERNATIONAL FEET

N752810.06
E8652795.95

Monument (s) Set (Procedures and Description)

Set a 1" id x 30" Galvanized Iron Pipe with a 2 1/2" Brass cap, at surface, stamped as shown above. Held ancient fence corner position as best evidence of original corner position. This position fits the GLO record very well.

References Set:

- A 5/8" x 30" iron rebar w/rpc #43406, lies S 88° W, 45.89'.
- A 5/8" x 30" iron rebar w/rpc #43406, lies S 88° W, 20.31'.
- A 5/8" x 30" iron rebar w/rpc #43406, lies S 2° E, 8.47'.
- A 5/8" x 30" iron rebar w/rpc #43406, lies South, 23.56'.

Location and Comments

From the intersection of Fulton Road and McCormmach Road go 1 mile South and 0.5 miles East.

Compass Declination

17° E

Surveyors Seal

REGISTERED
PROFESSIONAL
LAND SURVEYOR

Robert D. English
OREGON
JANUARY 11, 2005
ROBERT DOUGLAS ENGLISH
43406LS

RECEIVED BY:

Date: _____
Rec'd By: _____
No. _____

Firm / Agency

Survey One, LLC.
P.O. Box 382
Pendleton, OR 97801
(541) 276-2055

RENEWAL DATE: 12/31/11