

OREGON CORNER RESTORATION FORM

Section: 19, 20, 29, 30 Township: 3N Range: 33E
 County: Umatilla Date: 6/1/2011

Corner Designation: 3N33R05

Section corner common to Sections 19, 20, 29, 30, T3NR33E.

_____	Condition Report Only
X	Not Found
X	Remonumented
_____	Unrecorded
X	Surveyed In
X	Referenced Out


Previous Renewals / Surveys, etc.

Originally surveyed by Chaplin in 1864. He set a 15" x 12" x 10" stone.


Monuments and Accessories Found: (Condition and Source):

None.

Diagram

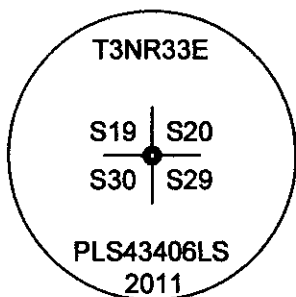

Sketch

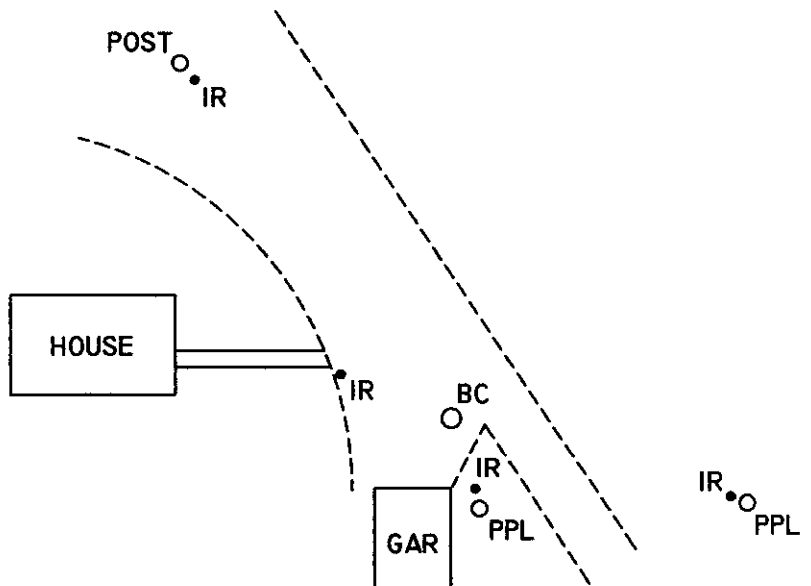

NAD 83/91
 OREGON STATE PLANE NORTH
 INTERNATIONAL FEET

N752803.57
 E8655445.11

Monument(s) Set (Procedures and Description):

A 1 1/8" x 30" galvanized iron pipe with a 2 1/2" brass cap, stamped as shown above, 1.3' below the surface. The corner location was reestablished by double proportionate method with good fit to field lines North and East.

References Set:

- A 5/8" x 30" iron rebar w/RPC #43406 lies N 38° W, 108.30', at a post.
- A 5/8" x 30" iron rebar w/RPC #43406 lies N 49° 50' W, 32.81'.
- A 5/8" x 30" iron rebar w/RPC #43406 lies S 15° 20' E, 19.71', at a power pole.
- A 5/8" x 30" iron rebar w/RPC #43406 lies S 64° 40' E, 110.73', at a power pole.

Location and Comments:

The corner is located 1/2 mile North and 1/2 mile West of the intersection of Myrick Rd. and Elgin Rd., at end of private gravel road, near old ranch house and out buildings.

Compass Declination

17° E

Surveyors Seal

REGISTERED
 PROFESSIONAL
 LAND SURVEYOR

Robert D. English
 OREGON
 JANUARY 11, 2005
 ROBERT DOUGLAS ENGLISH
 43406LS

RENEWAL DATE: 12/31/13

RECEIVED BY:

Date: 12-6-7/10/2012
 Rec'd By: S. Oles
 No. 12-094-C

Firm / Agency

Survey One, LLC.
 P.O. Box 382
 Pendleton, OR 97801
 (541) 276-2055