

OREGON CORNER RESTORATION FORM

Section 29
County Umatilla

Township 3N
Date: 03/11/11

Range 33E

Corner Designation: 3N33R9

Corner common to sections 20,21,28 and 29, T3NR33E.

- Condition Report Only
- Not Found
- Remonumented
- Unrecorded
- Surveyed In
- Referenced Out


Previous Renewals / Surveys, etc.

Originally Surveyed by Chaplin in 1864. He set a stone, 20"x10"x10" for the corner.
Wells set a 5/8" iron rebar with an aluminum cap, with a small mound of stone.

Monuments and Accessories Found: (Condition and Source)


- A 5/8" ir w/rpc #1106, lies S 87° E, 22.5'.
- A 5/8" ir w/rpc #1106, lies N 24° W, 24.0'.
- A 5/8" ir w/rpc #1106, lies N 30° W, 64.7'.
- A 5/8" ir w/rpc #1106, lies N 89° 30' W, 76.5'.

Diagram

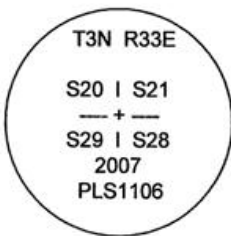

FIELD LINES

Sketch

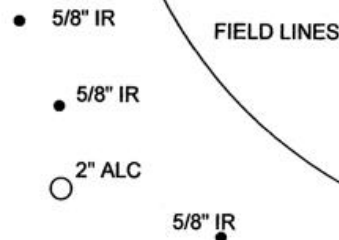

NAD 83/91
OREGON STATE PLANE NORTH
INTERNATIONAL FEET

N752932.81
E8660724.79

Monument (s) Set (Procedures and Description)

None.

References Set:

None.

Location and Comments

Corner falls at top of small ravine at the crest of the plateau approx. 1/4 mile North of Wild Horse Creek Road, and approx. 1/4 East of Myrick Road.

Compass Declination

17° E

Surveyors Seal

REGISTERED
PROFESSIONAL
LAND SURVEYOR

Robert D. English
OREGON
JANUARY 11, 2005
ROBERT DOUGLAS ENGLISH
43406LS

RECEIVED BY:

Date: _____
Rec'd By: _____
No. _____

Firm / Agency

Survey One, LLC.
P.O. Box 382
Pendleton, OR 97801
(541) 276-2055

RENEWAL DATE: 12/31/11