

**OREGON CORNER RESTORATION FORM**

Section: 28, 33 Township: 3N Range: 33E  
County: Umatilla Date: 8/30/2011

Corner Designation: 3N33V11

Quarter corner common to Sections 28, 33, T3NR33E.

<input checked="" type="checkbox"/>	Condition Report Only
<input type="checkbox"/>	Not Found
<input type="checkbox"/>	Remonumented
<input type="checkbox"/>	Unrecorded
<input type="checkbox"/>	Surveyed In
<input checked="" type="checkbox"/>	Referenced Out

**Previous Renewals / Surveys, etc.**

Originally surveyed by Chaplin in 1864. He set a post in a mound of earth with charred stake and pits.

In 1871 Moody set a 14" x 14" x 7" stone.

In 1887 Curin and Noland buried a charred stake with a mound of earth and pits.


In 1902 Macomber found the corner in Private Survey #135 as recorded in Book #1, pp. 458, 459.

In 1992 Harris set a 2 1/4" brass cap on a 30" pipe, with plastic capped witness corners 25.0' to the North and 25.0' to the West, in Survey 92-63-B.

**Monuments and Accessories Found: (Condition and Source):**

A 2 1/2" brass cap, stamped as shown below, flush with the surface.


Diagram

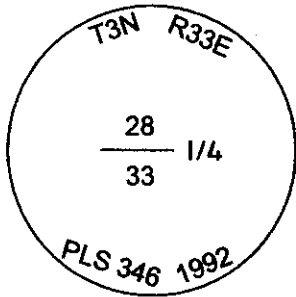

NAD 83/91  
OREGON STATE PLANE NORTH  
INTERNATIONAL FEET

N747679.51  
E8663475.05

Sketch

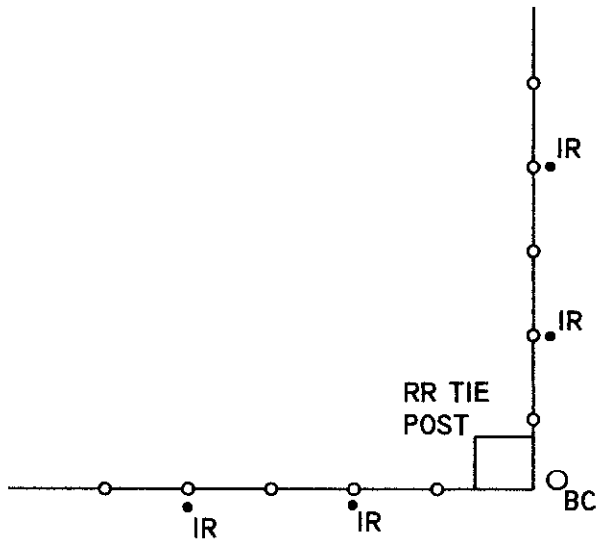

**Monument(s) Set (Procedures and Description):**

None.

**References Set:**

- A 5/8" x 30" iron rebar w/RPC #43406 lies N 3° E, 37.36', at the fourth steel fence post North of the fence corner.
- A 5/8" x 30" iron rebar w/RPC #43406 lies N 4° E, 18.95', at the second steel fence post North of the fence corner.
- A 5/8" x 30" iron rebar w/RPC #43406 lies S 89° W, 13.67', at the second steel fence post West of the fence corner.
- A 5/8" x 30" iron rebar w/RPC #43406 lies S 89° 40' W, 29.92', at the fourth steel fence post West of the fence corner.

**Location and Comments:**

The corner is located 1/2 mile West of the intersection of South Market Rd. and Hwy. 11.

**Compass Declination**

17° E

**Surveyors Seal**

REGISTERED  
PROFESSIONAL  
LAND SURVEYOR

*Robert D. English*  
OREGON  
JANUARY 11, 2005  
ROBERT DOUGLAS ENGLISH  
43406LS

RENEWAL DATE: 12/31/13

**RECEIVED BY:**

Date: 7/10/2012  
Rec'd By: S. Oles  
No. 12-094-C

**Firm / Agency**

Survey One, LLC.  
P.O. Box 382  
Pendleton, OR 97801  
(541) 276-2055