

OREGON CORNER RESTORATION FORM

Section: 26, 27, 34, 35 Township: 3N Range: 33E
County: Umatilla Date: 6/3/2011

Corner Designation: 3N33V17

Section corner common to Sections 26, 27, 34, 35, T3NR33E.

_____	Condition Report Only
_____	Not Found
_____ X _____	Remonumented
_____	Unrecorded
_____	Surveyed In
_____ X _____	Referenced Out


Previous Renewals / Surveys, etc.

Originally surveyed by Chaplin in 1864. He set a post in a mound of earth.
In 1871 Moody set a post in a mound of earth.
In 1887 Currin and Noland set a charred stake 12" in the ground.
In 2009 Wells found a railroad spike of unknown origin in Survey 09-088-C.
In 2009 Roberts found a railroad spike of unknown origin in Survey 09-100-C.


Monuments and Accessories Found: (Condition and Source):

A railroad spike of unknown origin.

Diagram

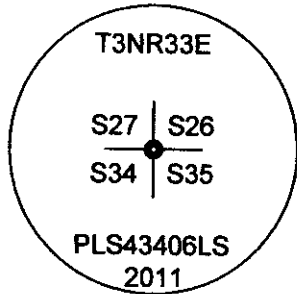

Sketch

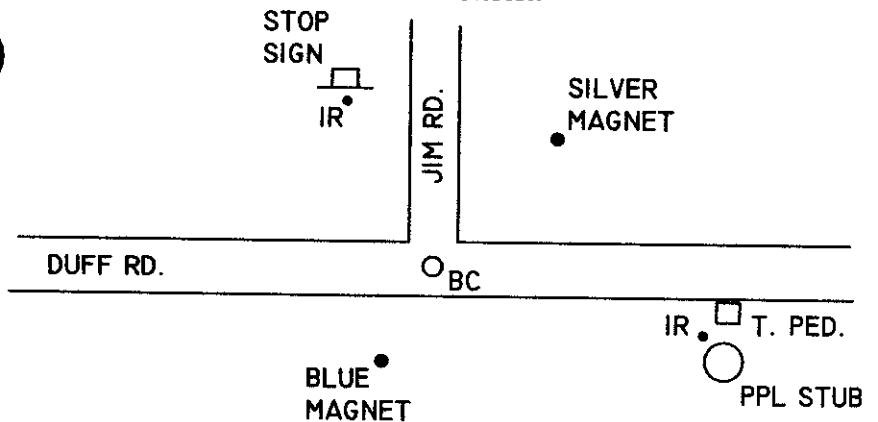

NAD 83/91
OREGON STATE PLANE NORTH
INTERNATIONAL FEET

N747900.15
E8671434.89

Monument(s) Set (Procedures and Description):

A 1 1/8" x 30" galvanized iron pipe with 2 1/2" brass cap, stamped as shown above.
The monument was set at the location of the existing railroad spike in the intersection of Duff Rd. and Jim Rd.

References Set:

"Deep One" magnets by Bermtsen.
A 5/8" x 30" iron rebar w/RPC #43406 lies N 27° W, 48.63', at a stop sign.
A silver magnet lies N 45° 10' E, 46.87', 1.3' deep.
A 5/8" x 30" iron rebar w/RPC #43406 lies S 76° E, 70.88', at a cut off power pole.
A blue magnet lies S 29° 10' W, 27.98', 1.3' deep.

Location and Comments:

The corner is located in the intersection of Duff Rd. and Jim Rd.

Compass Declination

17° E

Surveyors Seal

REGISTERED
PROFESSIONAL
LAND SURVEYOR

Robert D. English

OREGON
JANUARY 11, 2005
ROBERT DOUGLAS ENGLISH
43406LS

RECEIVED BY:

Date: 7/10/2012
Rec'd By: S. [Signature]
No. 12-094-C

Firm / Agency

Survey One, LLC.
P.O. Box 382
Pendleton, OR 97801
(541) 276-2055

RENEWAL DATE: 12/31/13