

**OREGON CORNER RESTORATION FORM**

Section: 36, 31 Township: 3N Range: 32E, 33E  
County: Umatilla Date: 2/11/11

Corner Designation: 3N33X01

Quarter corner common to Sections 36, T3NR32E; 31, T3NR33E.

Condition Report Only  
 Not Found  
 Remonumented  
 Unrecorded  
 Surveyed In  
 Referenced Out


**Previous Renewals / Surveys, etc.**

Originally surveyed by Thompson in 1864. He set a post in a mound of earth.  
In 1904 J. Kimbrell set an 18" x 8" x 7" stone at the proportioned point, as recorded in Private Survey No. 180, Book 1, pp. 526-527.  
In 2001 Haddock set a 2 1/4" brass cap in Survey 01-81-C.


**Monuments and Accessories Found: (Condition and Source):**

A 2 1/4" brass cap.  
A 5/8" iron rebar w/RPC PLS852 lies S 18° E, 50.06'. Haddock found this accessory at S 17° 46' 02" E, 49.99' in X1-01-81C.

**Diagram**

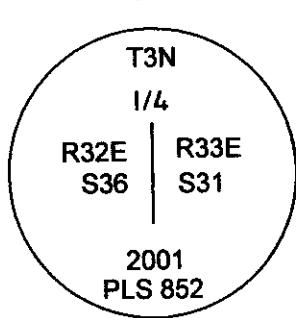

**Sketch**

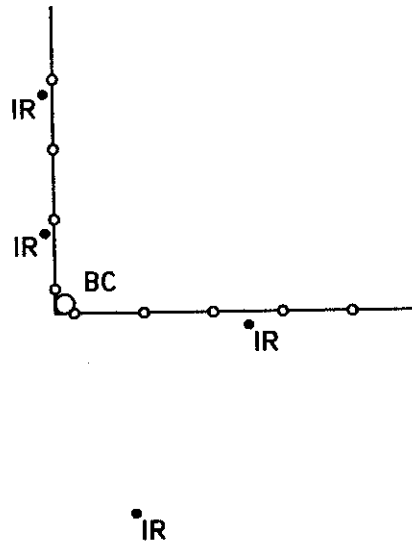

NAD 83/91  
OREGON STATE PLANE NORTH  
INTERNATIONAL FEET

N744807.54  
E8650379.35

**Monument(s) Set (Procedures and Description):**

None.

**References Set:**

A 5/8" x 30" iron rebar w/YPC #43406 lies N 3° 20' W, 15.11'  
A 5/8" x 30" iron rebar w/YPC #43406 lies N 1° 20' W, 45.12'  
A 5/8" x 30" iron rebar w/YPC #43406 lies S 88° E, 29.91'

**Location and Comments:**

The corner is located 2 1/2 miles South of the intersection of Fulton Rd. and McCormach Rd.

**Compass Declination**

17° E

**Surveyors Seal**

REGISTERED  
PROFESSIONAL  
LAND SURVEYOR

*Robert D. English*

OREGON  
JANUARY 11, 2005  
ROBERT DOUGLAS ENGLISH  
43406LS

RENEWAL DATE: 12/31/13

**RECEIVED BY:**

**Firm / Agency**

Survey One, LLC.  
P.O. Box 382  
Pendleton, OR 97801  
(541) 276-2055

Date: 7/10/2012  
Rec'd By: S. Oles  
No. 12-094-C