

**OREGON CORNER RESTORATION FORM**

Section: 36, 31 Township: 3N Range: 33E, 34E  
 County: Umatilla Date: 11/1/2011

Corner Designation: 3N33Y25

South Sixteenth corner common to Sections 36, T3NR33E; 31, T3NR34E.

Condition Report Only  
 Not Found  
 Remonumented  
 Unrecorded  
 Surveyed In  
 Referenced Out


**Previous Renewals / Surveys, etc.**

Originally surveyed by Krumbein in 1971. He set a 1 1/2" iron pipe with 2 1/2" brass cap in Survey 03-295-B. Caps set in this survey were old stock originally intended to be used to mark allotment corners.

**Monuments and Accessories Found: (Condition and Source):**

A 2 1/2" brass cap, stamped as shown below, 11" below the surface.

**Diagram**

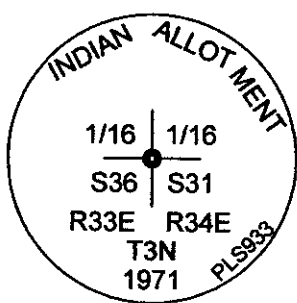

**Sketch**

ORANGE MAGNET

SILVER MAGNET

BC

8' M/L

BLUE MAGNET

PINK MAGNET

FIELD LINE

NAD 83/91  
 OREGON STATE PLANE NORTH  
 INTERNATIONAL FEET

N744077.95  
 E8682049.35

**Monument(s) Set (Procedures and Description):**

None.

**References Set:**

- "Deep One" magnets by Berntsen.
- An orange magnet lies N 36° W, 20.27', 1.6' deep.
- A silver magnet lies N 41° 15' E, 25.18', 1.5' deep.
- A pink magnet lies S 40° E, 25.55', 1.5' deep.
- A blue magnet lies S 35° 45' W, 24.92', 1.6' deep.

**Location and Comments:**

The corner is located 1/4 mile North of the intersection of North Cayuse Rd. and Kirkpatrick Rd.

**Compass Declination**

17° E

**Surveyors Seal**

REGISTERED  
 PROFESSIONAL  
 LAND SURVEYOR

*Robert D. English*  
 OREGON  
 JANUARY 11, 2005  
 ROBERT DOUGLAS ENGLISH  
 43406LS

RENEWAL DATE: 12/31/13

**RECEIVED BY:**

Date: 7/10/2012  
 Rec'd By: S. Oles  
 No. 12-094-C

**Firm / Agency**

Survey One, LLC.  
 P.O. Box 382  
 Pendleton, OR 97801  
 (541) 276-2055