

OREGON CORNER RESTORATION FORM

Section: 1, 6, 31, 36
County: Umatilla

Township: 2N, 3N
Date: 2/17/2011

Range: 33E, 34E

Corner Designation: 3N33Z25

Township corner common to Sections 1, T2NR33E; 6, T2NR34E; 31, T3NR34E; 36, T3NR33E.

<input checked="" type="checkbox"/>	Condition Report Only
<input type="checkbox"/>	Not Found
<input type="checkbox"/>	Remonumented
<input type="checkbox"/>	Unrecorded
<input type="checkbox"/>	Surveyed In
<input type="checkbox"/>	Referenced Out


Previous Renewals / Surveys, etc.

Originally surveyed by Thompson in 1864. He set a post in a mound of earth with a charred stake, pits, and trench.
 In 1871 Moody set a post in a mound of earth.
 In 1890 Currin and Noland recovered a post and placed 6 notches on the Northeast, South, and West sides.
 In 1918 Redfield recovered a monument.
 In 2001 Wells recovered a damaged monument and set a 1 1/2" x 30" galvanized iron pipe with a 2 1/2" brass cap and accessories.
 In 2003 Tomkins recovered a monument and accessories.


Monuments and Accessories Found: (Condition and Source):

A 2 1/2" brass cap, stamped as shown below, 22" below the surface.
 A 5/8" iron rebar w/YPC #1106 lies N 43° W, 25.5', 18" deep.
 A orange "Deep One" magnet lies N 30° E, 24.1', 24" deep.
 A 5/8" iron rebar w/YPC #1106 lies S 4° E, 46.0', flush with the surface.
 A blue "Deep One" magnet lies S 51° W, 68.5', 24" deep.

Diagram

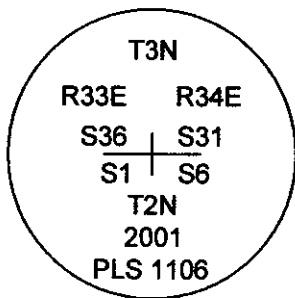

Sketch

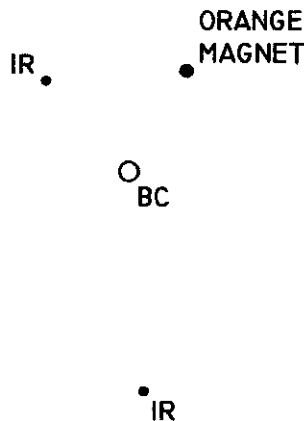

NAD 83/91
 OREGON STATE PLANE NORTH
 INTERNATIONAL FEET

 N742748.86
 E8682080.14

BLUE
MAGNET

Monument(s) Set (Procedures and Description):

None.

References Set:

None.

Location and Comments:

The corner is located just North of the road corner formed by the intersection of Kirkpatrick Rd. from the South and North Cayuse Rd. from the East.

Compass Declination

17° E

Surveyors Seal

REGISTERED
 PROFESSIONAL
 LAND SURVEYOR

Robert D. English
 OREGON
 JANUARY 11, 2005
 ROBERT DOUGLAS ENGLISH
 43406LS

RECEIVED BY:

Date: S. 2/10/2012
 Rec'd By: S. Oles
 No. 12-094-C

Firm / Agency

Survey One, LLC.
 P.O. Box 382
 Pendleton, OR 97801
 (541) 276-2055

RENEWAL DATE: 12/31/13