

OREGON CORNER RESTORATION FORM

Section: 31 Township: 3N Range: 33E
 County: Umatilla Date: 10/10/2011

Corner Designation: 3N33Z03

South quarter corner of Section 31 only.

_____	Condition Report Only
X	Not Found
X	Remonumented
_____	Unrecorded
X	Surveyed In
X	Referenced Out


Previous Renewals / Surveys, etc.

Originally surveyed by Thompson in 1864. He set a post in a mound of earth with charred stake, pits, and trench.
 In 1871 Moody set a post in a mound of earth.
 In 1887 Currin and Noland set a basalt stone 10" x 8" x 7" with a mound of earth alongside.
 In 1887 Currin and Noland found a basalt stone 10" x 8" x 7" with remnants of a mound.


Monuments and Accessories Found: (Condition and Source):

None.

Diagram

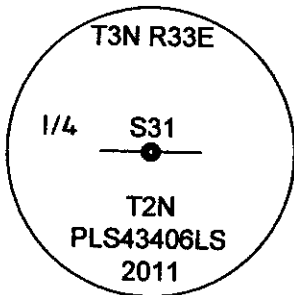

Sketch

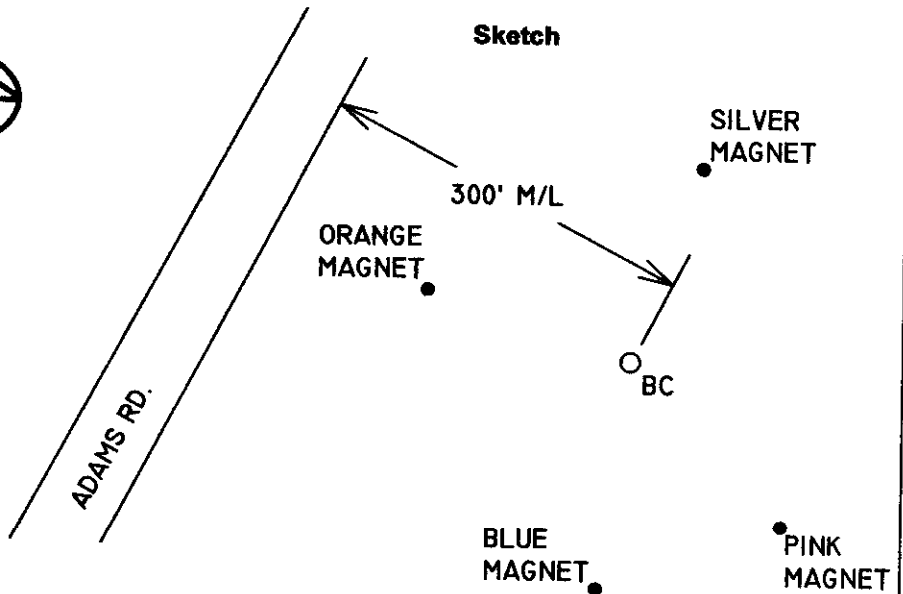

NAD 83/91
 OREGON STATE PLANE NORTH
 INTERNATIONAL FEET
 N742197.79
 E8653077.24

Monument(s) Set (Procedures and Description):

A 1 1/8" x 30" galvanized iron pipe with 2 1/2" brass cap, stamped as shown above, 1.8' below the surface. The corner was reestablished by using single proportionate method along the line held between neighboring monuments East and West.

References Set:

- "Deep One" magnets by Berntsen.
- An orange magnet lies N 70° 30' W, 22.63', 1.6' deep.
- A silver magnet lies N 19° 10' E, 21.56', 1.5' deep.
- A pink magnet lies S 41° 45' E, 23.61', 1.4' deep.
- A blue magnet lies S 9° 10' W, 24.09', 1.4' deep.

Location and Comments:

The corner is located 735', M/L, South of the intersection of Adams Rd. and McCormach Rd.

Compass Declination

17° E

Surveyors Seal

REGISTERED
 PROFESSIONAL
 LAND SURVEYOR

Robert D. English
 OREGON
 JANUARY 11, 2005
 ROBERT DOUGLAS ENGLISH
 43406LS

RENEWAL DATE: 12/31/13

RECEIVED BY:

Date: 11/10/2012
 Rec'd By: [Signature]
 No. 12-094-C

Firm / Agency

Survey One, LLC.
 P.O. Box 382
 Pendleton, OR 97801
 (541) 276-2055