

OREGON CORNER RESTORATION FORM

Section: 31, 32 Township: 3N Range: 33E
County: Umatilla Date: 8/17/2011

Corner Designation: 3N33Z05

Section corner common to Sections 31, 32, T3NR33E.

<u> </u>	X	Condition Report Only
<u> </u>		Not Found
<u> </u>		Remonumented
<u> </u>		Unrecorded
<u> </u>		Surveyed In
<u> </u>	X	Referenced Out


Previous Renewals / Surveys, etc.

Originally surveyed by Thompson in 1864. He set a post in a mound of earth.
In 1871 Moody set a post in a mound of earth.
In 1887 Currin and Noland set a post in a mound of earth.
In 1887 Currin and Noland found a post.
In 2001 D. Haddock set a 1 1/8" x 30" galvanized iron pipe with a 2 1/4" brass cap in Survey 01-81-C.
In 2008 W. Wells found a 2 1/4" brass cap in Partition Plat 2009-02.


Monuments and Accessories Found: (Condition and Source):

A 2 1/2" brass cap in a mound of stone, stamped as shown below.

Diagram

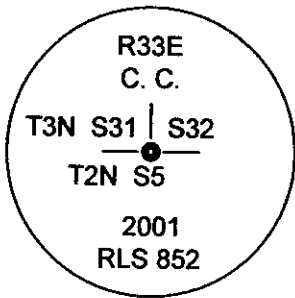

Sketch

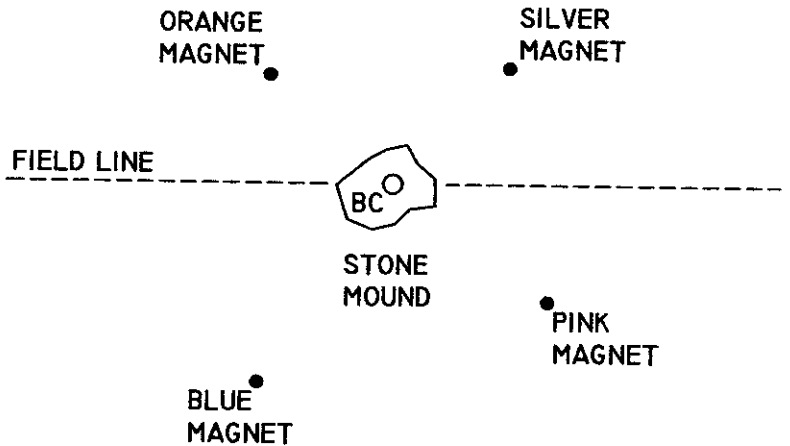

NAD 83/91
OREGON STATE PLANE NORTH
INTERNATIONAL FEET

N742244.50
E8655740.00

Monument(s) Set (Procedures and Description):

None.

References Set:

"Deep One" magnets by Berntsen.
An orange magnet lies N 48° W, 18.98', 1.3' deep.
A silver magnet lies N 46° E, 19.10', 1.4' deep.
A pink magnet lies S 52° E, 20.26', 1.3' deep.
A blue magnet lies S 35° W, 24.94', 1.3' deep.

Location and Comments:

The corner is located 1/2 mile East
Southeast of the intersection of
McCormach Rd. and Adams Rd.

Compass Declination

17° E

Surveyors Seal

REGISTERED
PROFESSIONAL
LAND SURVEYOR

Robert D. English
OREGON
JANUARY 11, 2005
ROBERT DOUGLAS ENGLISH
43406LS

RENEWAL DATE: 12/31/13

RECEIVED BY:

Date: 7/10/2012
Rec'd By: [Signature]
No. 12-094-C

Firm / Agency

Survey One, LLC.
P.O. Box 382
Pendleton, OR 97801
(541) 276-2055