

OREGON CORNER RESTORATION FORM

Section: 32 Township: 3N Range: 33E
County: Umatilla Date: 4/19/2012

Corner Designation: 3N33Z07

South Quarter Corner of Section 32 only.

_____	Condition Report Only
_____ X	Not Found
_____ X	Remonumented
_____	Unrecorded
_____ X	Surveyed In
_____ X	Referenced Out


Previous Renewals / Surveys, etc.

Originally surveyed by Thompson in 1864. He set a post in a mound of earth, with charred stake, pits, and trench.
In 1871 Moody set a post in a mound of earth.
In 1887 Currin and Noland set a 10" x 8" x 6" basalt stone, raised a mound of earth alongside, and dug pits East and West.
In 1887 Currin and Noland found a 10" x 8" x 6" stone, with pits and mound.


Monuments and Accessories Found: (Condition and Source):

None.

Diagram

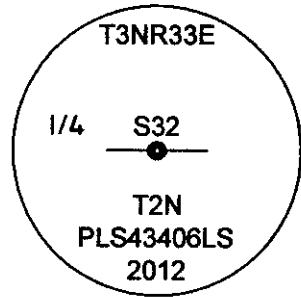

Sketch

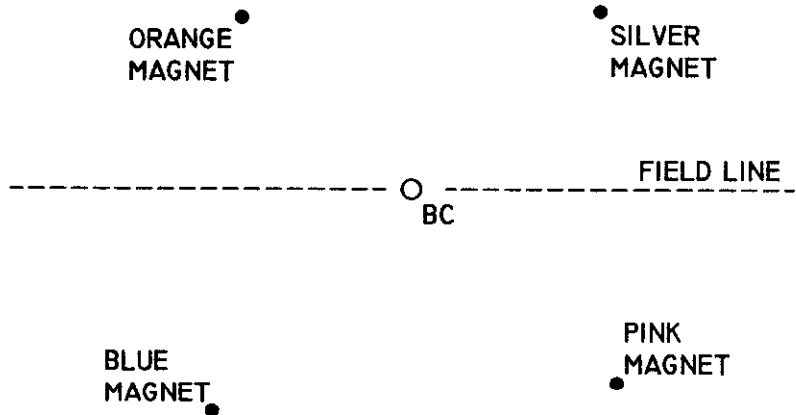

NAD 83/91
OREGON STATE PLANE NORTH
INTERNATIONAL FEET

N742283.67
E8658359.67

Monument(s) Set (Procedures and Description):

A 1 1/8" x 30" galvanized iron pipe with 2 1/2" brass cap, stamped as shown above, 1.5' below the surface. The corner location was reestablished by single proportionate method on the line between BLM caps on the North line of Township 2 North.

References Set:

"Deep One" magnets by Berntsen.
An orange magnet lies N 43° 55' W, 25.23', 1.6' deep.
A silver magnet lies N 47° 45' E, 26.94', 1.6' deep.
A pink magnet lies S 46° 30' E, 29.37', 1.6' deep.
A blue magnet lies S 42° 30' W, 30.97', 1.7' deep.

Location and Comments:

The corner is located 1 1/2 miles South and 1 mile West of the intersection of Hwy. 11 and South Market Rd., 400', M/L, South of the South edge of pavement of Hwy. 11.

Compass Declination

17° E

Surveyors Seal

REGISTERED
PROFESSIONAL
LAND SURVEYOR

Robert D. English
OREGON
JANUARY 11, 2005
ROBERT DOUGLAS ENGLISH
43406LS

RECEIVED BY:

Date: 7/10/14 2012
Rec'd By: [Signature]
No. 12-094-C

Firm / Agency

Survey One, LLC.
P.O. Box 382
Pendleton, OR 97801
(541) 276-2055

RENEWAL DATE: 12/31/13