

OREGON CORNER RESTORATION FORM

Section: 1, 12, 6, 7 Township: 3N Range: 33E, 34E
County: Umatilla Date: 2/14/2011

Corner Designation: 3N33E25

Section corner common to Sections 1, 12, T3NR33E;
Sections 6, 7, T3NR34E.

<input checked="" type="checkbox"/>	Condition Report Only
<input type="checkbox"/>	Not Found
<input type="checkbox"/>	Remonumented
<input type="checkbox"/>	Unrecorded
<input type="checkbox"/>	Surveyed In
<input checked="" type="checkbox"/>	Referenced Out


Previous Renewals / Surveys, etc.

Originally surveyed by Thompson in 1864. He set a post in a mound of earth with a charred stake, pits, and trench. In 1971 Staebler found charred stake and set a 5/8" x 36" iron pin with 2 brass cap Witness Corners, in Survey H-002-A. In 1976 Krumbein set a brass cap at the intersection of a road centerline and a field line, in Survey M-121-C.


Monuments and Accessories Found: (Condition and Source):

A 2 1/2" brass cap, 8" below the road surface.
A 2 1/2" brass cap witness corner lies S 2° E, 15.25', above the surface.

Diagram

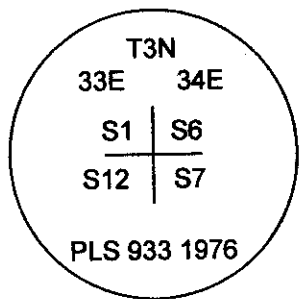

Sketch

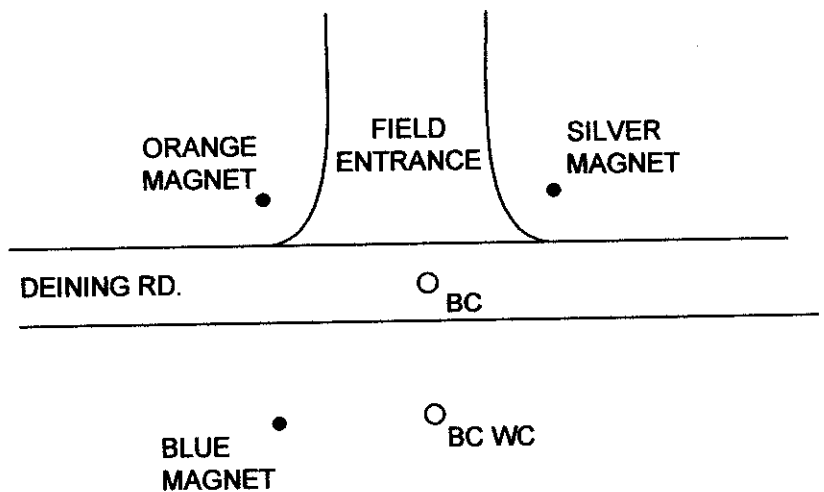

NAD 83/91
OREGON STATE PLANE NORTH
INTERNATIONAL FEET

N769261.26
E8681445.90

Monument(s) Set (Procedures and Description):

None.

References Set:

"Deep One" magnets by Berntsen.
An orange magnet lies N 52° 15' W, 44.29', 12" deep.
A silver magnet lies N 48° E, 21.55', 12" deep.
A blue magnet lies S 58° 15' W, 29.58', 12" deep.

Location and Comments:

The corner is located 1 1/2 miles East of the intersection of Helix Hwy. and Deining Rd.

Compass Declination

17° E

Surveyors Seal

REGISTERED
PROFESSIONAL
LAND SURVEYOR

Robert D. English
OREGON
JANUARY 11, 2005
ROBERT DOUGLAS ENGLISH
43406LS

RENEWAL DATE: 12/31/13

RECEIVED BY:

Date: 2/10/2012
Rec'd By: [Signature]
No. 12-094-C

Firm / Agency

Survey One, LLC.
P.O. Box 382
Pendleton, OR 97801
(541) 276-2055