

OREGON CORNER RESTORATION FORM

COUNTY: Umatilla DATE: 12/22/15

CORNER DESIGNATION: L-23, The Center Quarter Corner of Section 13, Township 3 North, Range 34 East, W.M.

PREVIOUS RENEWALS/SURVEYS ETC.: Corner originally established by Currin and Nolin under special contract dated May 4th, 1887. Notes State: Deposited charred stake 12 ins. in the ground for ¼ sec. corner.

MONUMENT AND ACCESSORIES FOUND: None. Held a point 1.0 foot East of the centerline of a railroad tie field marker post with field berms extending South, East, and West as the best remaining evidence of the corner.

MONUMENT MARKING DETAIL:

T3N R34
C1/4 S13
2015
PLS 54657

MONUMENT SET: At the corner point set a 2 3/8" brass cap on 1 ¼"x30" galvanized steel pipe with top flush with ground, 1.0 foot East of the centerline of a railroad tie field marker post. Monument marked as shown in "Monument Marking Detail".

From which:

A silver Deep-1 magnet buried 20" in the ground in a farmed field bears North 45° East, 25.5 feet.

A pink Deep-1 magnet buried 20" in the ground in a farmed field bears South 33° East, 31.1 feet.

A blue Deep-1 magnet buried 20" in the ground at the edge of the road bears South 41° West, 30.8 feet.

A silver Deep-1 magnet buried 20" in the ground in a farmed field bears North 39° West, 31.8 feet.


Buried bearing object tags with magnets. Attached witness post sign to railroad tie marker post by monument.

LOCATION AND COMMENTS: Corner is located at the intersection of field berms extending South, East, and west, 1.0 foot East of the centerline of a railroad tie field marker post. See Survey Map filed concurrently with this certificate for further information.

FIRM: Wells Surveying
P.O. Box 1696
Pendleton, OR 97801

COMPASS DECLINATION: 18° East Surveyor's Seal

/3N34L23

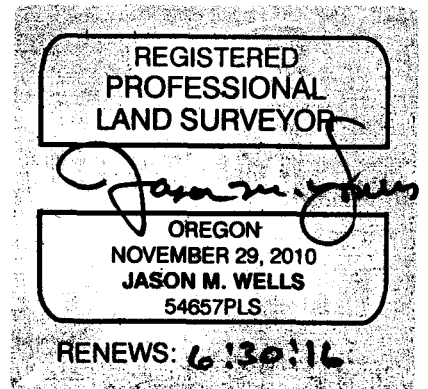

15-125-B