

# OREGON CORNER RESTORATION FORM

Section 18 Township 3N Range 35E  
 County Umatilla Date: 09-16-2004

Corner Designation: 3N35E1

_____x_____	Condition Report Only
	Not Found
	Remonumented
	Unrecorded
	Surveyed In
	Referenced Out


Previous Renewals / Surveys, etc.  
 Corner set by Dwight M. Bartleson LS 2166 in the year 2000.

**Monument and Accessories Found: ( condition and source )**


Found 3.25" dia. brass cap stamped as shown in the diagram below, and in the attached photographs. Brass cap was located on Curl Road (County road # 736) and Pambrun Road (County Road # 737). The cap is exposed and embedded below the surface of the pavement in the NW part of the intersection.

Found no references or bearing-object signs at intersection.

DIAGRAM

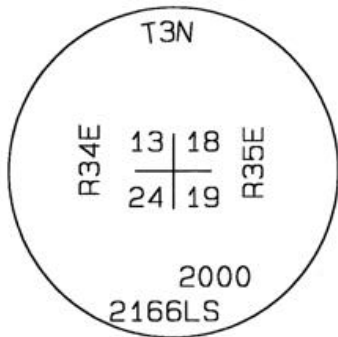

SKETCH

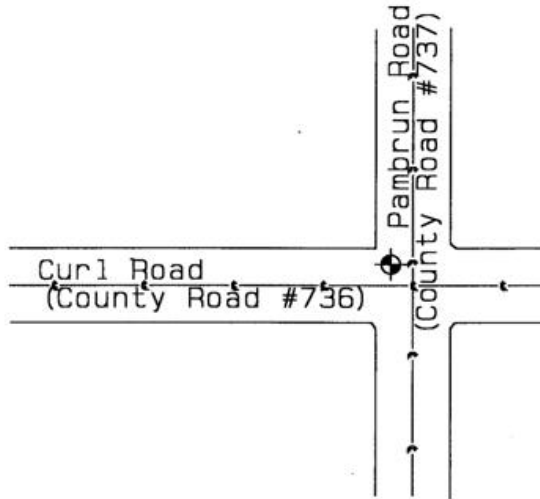

**REFERENCES:**

Single point GPS tie.  
 Latitude 45°43'53.9"N  
 Longitude 118°29'52.0"W  
 NAD 83 (1991)

Oregon State Plane Coord. - North Zone  
 Northing 759180'  
 Easting 8713330'  
 Ellipsoidal Height 1750'

RECEIVED BY: \_\_\_\_\_

Date: \_\_\_\_\_  
 Rec'd By: \_\_\_\_\_  
 No. 05-011-R

Firm / Agency

Haddock Surveying  
 P. O. Box 1574  
 Pendleton, OR 97801  
 (541) 276-2174

REGISTERED  
 PROFESSIONAL  
 LAND SURVEYOR

*David L. Haddock*

OREGON  
 JULY 12, 1968  
 DAVID L. HADDOCK  
 852