

**OREGON CORNER RESTORATION FORM**

COUNTY: Umatilla DATE: 1/15/16

CORNER DESIGNATION: T-17, The West Quarter Corner of Section 26, Township 3 North, Range 34 East, W.M.

PREVIOUS RENEWALS/SURVEYS ETC.: Most recent field notes for the corner by Currin and Noland under special contract dated May 4<sup>th</sup>, 1887 state: Set post 3 ft. long, 3 ins. square, 24 inches in the ground for 1/4 sec. corner.

MONUMENT AND ACCESSORIES FOUND: None. Held the intersection of the centerline of Johnley Road (North-South) with a field berm extending West as the best remaining evidence of the corner.

**MONUMENT MARKING DETAIL:**

T3N R34E  
1/4  
S27|S26  
2016  
PLS 54657

MONUMENT SET: At the corner point set a 2 3/8" brass cap on 1 1/4"x30" galvanized iron pipe with top 10" below gravel road surface. Monument marked as shown in "Monument Marking Detail".

**From which:**


A silver Deep-1 magnet buried 22" in the ground in a farmed field bears North 53° East, 29.1 feet.  
A pink Deep-1 magnet buried 22" in the ground in a farmed field bears South 52° East, 26.1 feet.  
A blue Deep-1 magnet buried 22" in the ground in a farmed field bears South 51° West, 39.6 feet.  
A orange Deep-1 magnet buried 22" in the ground in a farmed field bears North 51° East, 38.3 feet.  
Buried bearing object signs with all magnets.

LOCATION AND COMMENTS: Corner is located at the intersection of the visual centerline of Johnley Road (North-South) and a field berm extending West. See Survey Map filed concurrently with this certificate for further information.

FIRM: Wells Surveying  
P.O. Box 1696  
Pendleton, OR 97801

COMPASS DECLINATION: 18° East Surveyor's Seal

/3N34T17

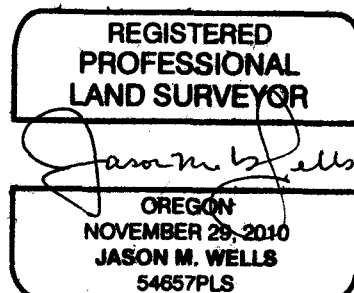

RENEWS: 6/30/16

16-008-C