

Index
File No. J-21


CORNER RECORD (SEARCH)
(Ref. FSM 7151.4)

Tract or Survey No. C Cor. No. J-21

T 3N R. 36E R.D. _____ County _____

Merid. _____ N.F. _____ State _____

CORNER DIAGRAM

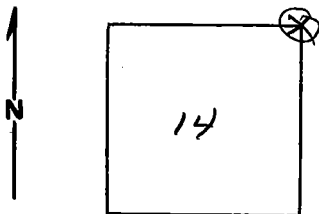

DESCRIBE CORNER MONUMENT FOUND

County Record: Line #5
Drawing # 1097, 1" steel Rod, Hayes of Harris - 1956.
" " 1096, Stake of Rock, Stamm of Offgen(?) - 1950.
" " 1095, 3/4" Rod, Gray - 1955.

DESCRIBE BEARING TREES OR OTHER OFFICIAL ACCESSORIES FOUND

Gray 1955 →
Drawing # 1095

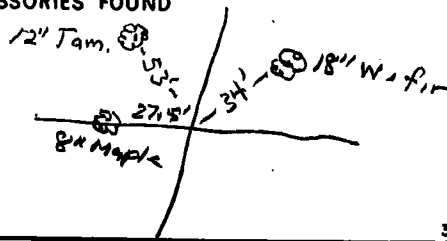


PHOTO IDENTIFICATION DATA

Photo No. _____
Filed At. _____
Object Ident. _____
Ident. By _____
Signature _____

DESCRIBE CORNER LOCATION RELATIVE TO NEAR-BY FEATURES, ALSO HOW TO REACH CORNER.

3/4" x 30" steel Rod set by Gray 1955
(Drawing # 1095)

PLANE COORDINATE POSITION DATA

State _____ Zone _____
X _____
Y _____
Estab. By _____
Agency _____

Signature
JGH

Title

Division

Headquarters

Date
2-5-79

7100-52-(3/68)

CORNER RECORD (PERPETUATION)

MONUMENT : DESCRIBE NEW MONUMENT SET, OR WORK DONE TO PRESERVE EXISTING MONUMENT

ACCESSORIES : DESCRIBE NEW BT'S WITNESS OBJECTS ETC. ESTABLISHED, OR WORK DONE TO PRESERVE EXISTING EVIDENCE

Work Done By _____ **Title** _____ **Date** _____ **State Registration No.**
or Agency _____

Certified Cor. Record Prepared ? Yes No **Filed At:** _____ **Date** _____

REMARKS

Index File No. **T.** **R.** **M.** **Tract or Surv. No.** **Cor.** **13**
U.S. G.P.O. 1977-725-576/586