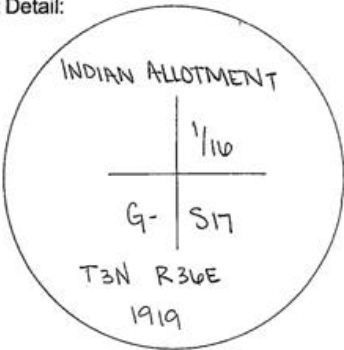
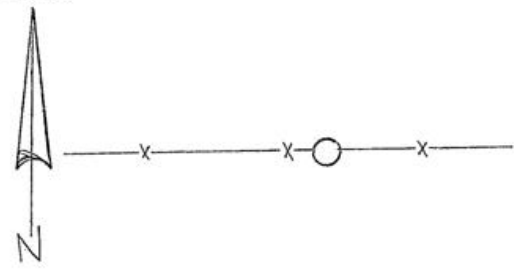
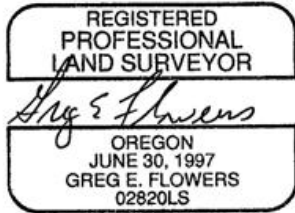


ORIGINAL PUBLIC LAND CORNER REPORT / RESTORATION REPORT
 Umatilla County Surveyor's Office

SECTION 17	TOWNSHIP 3N	RANGE 36E
COUNTY: Umatilla		DATE 6/20/08
CORNER DESIGNATION: M-8 Southeast 1/16 corner common to sections 17		(Please check one) <input type="checkbox"/> Condition Report Only <input type="checkbox"/> Not Found <input checked="" type="checkbox"/> Renewed <input type="checkbox"/> Unrecorded <input type="checkbox"/> Surveyed In <input type="checkbox"/> Referenced Out
Previous Renewals / Surveys, etc. U.S. Indian Services Surveyor C.E. Redfield, set a Iron Pipe in 1919.		
Monument(s) & Accessories Found: (Condition & Source) Found a 2" Galvanized Iron Pipe with a 2 1/2" Brass Cap, 0.7 feet North of an East-West Fence Line. The monument was leaning Southerly. I straightened the Monument and rebuilt the Stone Mound around the Monument.		
Monument Detail: 	Sketch: 	
Monument Set (Procedures and Description):		
New Accessories: NONE		
Location & Comments: The Corner is located on an open South facing Ridge.		Compass Declination:
Firm / Agency USKH Address: 5 N. Colville St., Walla Walla, Wa 99632		SURVEYOR'S SEAL 
Party Chief Greg E. Flowers		
Notes		
Witness Damon Locke		

RENEWS 12/31/09

6/30/08

08-112-c