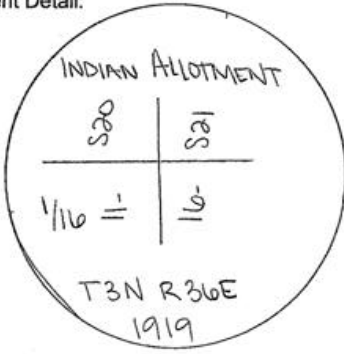



OREGON PUBLIC LAND CORNER REPORT / RESTORATION REPORT  
Umatilla County Surveyor's Office

SECTION 20 and 21	TOWNSHIP 3N	RANGE 36E
COUNTY: Umatilla		DATE 6/20/08
CORNER DESIGNATION: O-9 North 1/16 corner common to sections 20 and 21		(Please check one) <input checked="" type="checkbox"/> Condition Report Only <input type="checkbox"/> Not Found <input type="checkbox"/> Renewed <input type="checkbox"/> Unrecorded <input type="checkbox"/> Surveyed In <input type="checkbox"/> Referenced Out
Previous Renewals / Surveys, etc. This corner was originally set by U.S. Indian Services Surveyor C.E. Redfield in 1919		
Monument(s) & Accessories Found: (Condition & Source) Found a 2" galvanized iron pipe with a 2 1/2" brass cap laying next to a scattered mound of stones. Reset the found monument in the center of the stone mound and rebuilt the mound around it.		
Monument Detail: 	Sketch:	
Monument Set (Procedures and Description):		
New Accessories:		
Location & Comments: Monument is on an open south slope.		Compass Declination:
Firm / Agency USKH Inc. Address: 5 N. Colville St. Walla Walla, WA 99362 Party Chief Damon Locke		<b>SURVEYOR'S SEAL</b>  
Notes		
Witness		

RENEWS 12/31/08

6/30/08