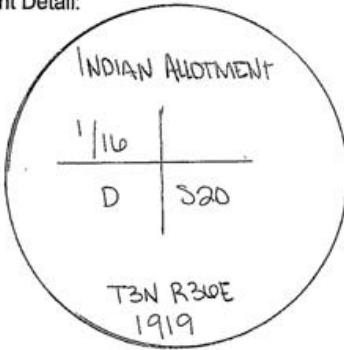
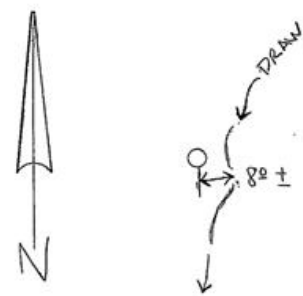
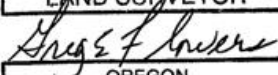


OR **ON PUBLIC LAND CORNER REPORT / RESTORATION REPO.**
 Umatilla County Surveyor's Office

SECTION 20	TOWNSHIP 3N	RANGE 36E
COUNTY: Umatilla		DATE 6/20/08
CORNER DESIGNATION: P-6 Center West 1/16 corner, section 20		(Please check one) <input type="checkbox"/> Condition Report Only <input type="checkbox"/> Not Found <input type="checkbox"/> Renewed <input type="checkbox"/> Unrecorded <input type="checkbox"/> Surveyed In <input type="checkbox"/> Referenced Out
Previous Renewals / Surveys, etc. U.S. Indian Services Surveyor, C.E. Redfield set an Iron Post in 1919.		
Monument(s) & Accessories Found: (Condition & Source) Found a 2" Galvanized Iron Pipe with a 2 1/2" Brass Cap, protruding 5", 8 feet West of the bottom of a North-South Draw. The markings on the cap are damaged and Unclear.		
Monument Detail: 	Sketch: 	
Monument Set (Procedures and Description):		
New Accessories:		
Location & Comments: The corner is located on the west side of a steep South Draw, 8 feet West of the Bottom.	Compass Declination:	
Firm / Agency USKH Address: 5 N. Colville St., Walla Walla, Wa 99632	SURVEYOR'S SEAL	
Party Chief Greg E. Flowers	REGISTERED PROFESSIONAL LAND SURVEYOR 	
Notes	OREGON JUNE 30, 1997 GREG E. FLOWERS 02820LS	
Witness Damon Locke	RENEWS 12/31/09 6/30/08	

178-112-c