

USDA-FOREST SERVICE

Index
File No. 2-25

CORNER RECORD (SEARCH)
(Ref. FSM 7151.4)

Tract or
Survey No. _____ Cor.
No. _____


T 3N R. 38E

R.D. _____ County UNION

Merid. WILLAMETTE

N.F. UMATILLA State OREGON

CORNER DIAGRAM

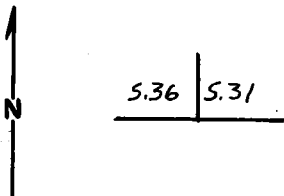

DESCRIBE CORNER MONUMENT FOUND

NONE

DESCRIBE BEARING TREES OR OTHER OFFICIAL ACCESSORIES FOUND

- ① A 32" D.B.H. DOUGLAS FIR SNAG, S. 40°W., 13.9', WITH SCRIBES VISIBLE
- ② A 36" D.B.H. WHITE FIR SNAG, N. 43°W., (N. 30°W. 65 LINKS) 50.8', ORIG. B.T. WITH REVERSE SCRIBES VISIBLE ON BROKEN PIECE. N.E. B.T. GONE.

PHOTO IDENTIFICATION DATA

Photo No. _____
Filed At. _____
Object Ident. _____
Ident. By _____
Signature

PLANE COORDINATE POSITION DATA

State _____ Zone _____
X _____
Y _____
Estab. By _____
Agency

DESCRIBE CORNER LOCATION RELATIVE TO NEAR-BY FEATURES, ALSO HOW TO REACH CORNER

GO TO END OF GRAVEL ON 3128 ROAD, GO LEFT 0.2 MILES TAKE RT. FORK, GO RT. 150' TO EDGE OF CUTTING, SEE LOCATION TAG ON TREE ON LT., COR. IS 425' EAST, AT CORNER OF CUTTING.

Signature

Clayton J. Ward

Title
LAND SURVEYOR

Division

Headquarters


Date

SEPT. 14, 1982

7100-52-(3/68)

CORNER RECORD (PERPETUATION)

MONUMENT: DESCRIBE NEW MONUMENT SET, OR WORK DONE TO PRESERVE EXISTING MONUMENT
 SET A 2 1/2" DIAM. BRASS CAP 4" ABOVE GROUND IN A 2"X30" G.I. PIPE
 AT CORNER POINT, AND STAMPED PER SKETCH.

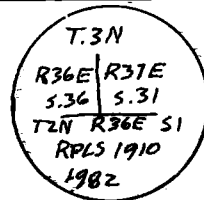

ACCESSORIES: DESCRIBE NEW BT'S WITNESS OBJECTS ETC. ESTABLISHED, OR WORK DONE TO PRESERVE EXISTING EVIDENCE

- ① A 16" D.B.H. DOUGLAS FIR, N. 87° E., 36.7', SCRIBED T3N R37E S.31 B.T.
- ② A 14" D.B.H. SPRUCE, N. 80° W., 43.0', SCRIBED T3N R36E S.36 B.T.

BOTH HAVE BRASS WASHERS RPLS 1910

Work Done By C.J. MARTIN Title LAND SURVEYOR Date 9-14-82 State Registration No. _____
 or Agency _____

Certified Cor. Record Prepared? Yes No Filed At: UMATILLA COUNTY SURV. OFFICE Date 9-82

REMARKS

Index
File No. Z-25

CORNER RECORD (SEARCH)

(Ref. FSM 7151.4)

Tract or

Cor.

T 3N R. 36E

R.D. WALLA WALLA County UMATILLA


Survey No. _____

No. _____

Merid. WILL

N.F. UMATILLA State OREGON

CORNER DIAGRAM

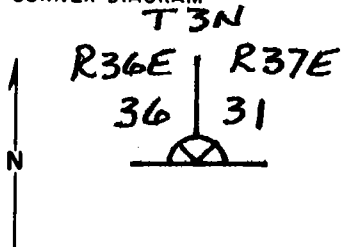

DESCRIBE CORNER MONUMENT FOUND

NONE

DESCRIBE BEARING TREES OR OTHER OFFICIAL ACCESSORIES FOUND

ORIG. 20" FIR IS NOW A 26" FIR SNAG. I OPEN & FIND SCRIBING & REVERSE. BEARS S40°W, 13.9 FT.

ORIG. 18" FIR IS NOW A 26" FIR NEARLY DEAD - THIS TREE HAS BEEN PREVIOUSLY OPENED & IS HOLLOW. I CAN SEE FRAGMENTARY REVERSE SCRIBES WITH A MIRROR BEARS N30°W, 42.9 FT. ORIG N.E. B.T. IS GONE.

DESCRIBE CORNER LOCATION RELATIVE TO NEAR-BY FEATURES, ALSO HOW TO REACH CORNER

CORNER IS 200' NORTH OF JEEP ROAD & 150' N.E. OF SECTION CORNER LOCATION AS IDENTIFIED BY B.C.C.

PHOTO IDENTIFICATION DATA

Photo No. _____
Filed At. _____
Object Ident. _____
Ident. By _____
Signature

PLANE COORDINATE POSITION DATA

State _____ Zone _____
X _____
Y _____
Estab. By _____
Agency

Signature Dennis L. Gaylord Title _____ Division PLS 1636 Headquarters _____ Date 6-23-82 7100-52 (3.68)

CORNER RECORD (PERPETUATION)

MONUMENT : DESCRIBE NEW MONUMENT SET, OR WORK DONE TO PRESERVE EXISTING MONUMENT

ACCESSORIES : DESCRIBE NEW BT'S WITNESS OBJECTS ETC. ESTABLISHED, OR WORK DONE TO PRESERVE EXISTING EVIDENCE

Work Done By _____ Title _____ Date _____ State Registration No. _____
or Agency _____

Certified Cor. Record Prepared ? Yes No Filed At: _____ Date _____

REMARKS

Index File No.

T.

R.

M.

Tract or Surv. No.

Cor.