


CERTIFIED RECORD OF LAND CORNER MONUMENTATION

HISTORY OF ORIGINAL CORNER ESTABLISHMENT:

Corner not previously established.

T4N R37E Z-12

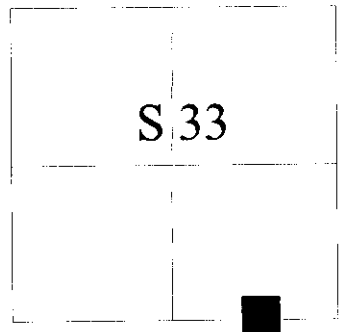

DESCRIPTION OF CORNER EVIDENCE FOUND:

None.

DESCRIPTION OF MONUMENT AND ACCESSORIES I ESTABLISHED TO PERPETUATE THE ORIGINAL LOCATION OF THIS CORNER:

At position determined by survey, I set a 5/8" x 30" iron pin with a 2 1/2" aluminum cap marked as shown below, 30 inches in the ground, from which:

A 7 inch White Fir bears West, a distance of 6.85 feet, marked E1/16 S4 BT.

A 6 inch Western Larch bears North 46° West, a distance of 17.0 feet, marked E1/16 S33 BT


A steel fencepost falls 1 foot East of the monument.

I hereby certify that the corner was monumented on July 16th, 2013.

REGISTERED
PROFESSIONAL
LAND SURVEYOR

[Signature]
OREGON
June 2, 2010
JEFFERY S. HSU
83571

Renewal Date: June 30, 2015

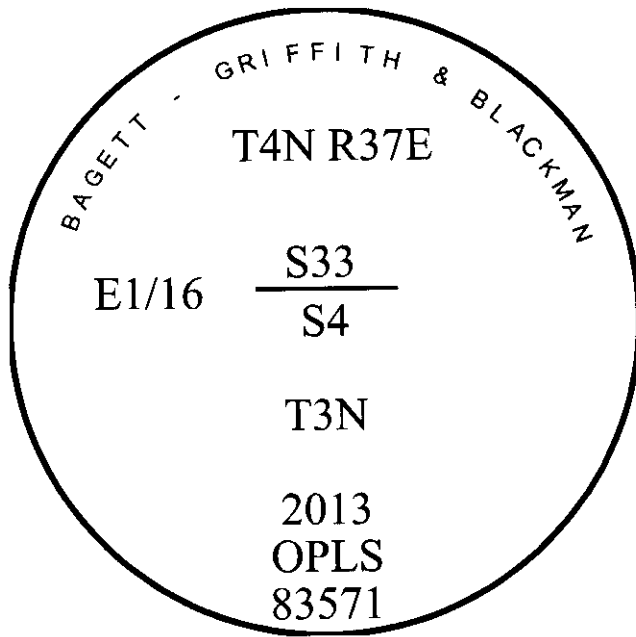

I used a steel tape and magnetic compass in the establishment of the new accessories. I use 16° East declination. The distance to the new bearing trees are to a 60d spike driven into the right side of the root crown of the bearing trees. Attached brass washer marked OPLS 83571 to BT Blaze.

RECEIVED BY
Umatilla County Surveyor
Date: 8/9/2013
Rec'd By: [Signature]
No.: 13-213-C