

**CERTIFIED RECORD OF LAND CORNER MONUMENTATION**

**HISTORY OF ORIGINAL CORNER ESTABLISHED:**


Corner established in Survey Number 86-86, by Victor M. McLind. Umatilla County Monumentation record states:

Set 2"x30" Aluminum Pipe with 2 1/2" Al. Cap, marked as shown above, 24" in ground, from which:

A 9" Fir, scribed "NE 1/16 S2 BT" bears S60 1/2°W, 9.6 Ft.  
A 9" Fir, scribed "NE 1/16 S2 BT" bears S11°E, 21.8 Ft.

Set a steel post 3 Ft. S. of corner, with sign 54-4.  
Painted a red band around both BT's and attached sign 54-3 above blaze and sign 54-4 to back of trees.

T 3 N R 37 E B-20

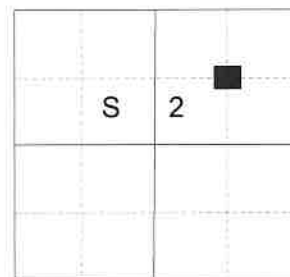

**DESCRIPTION OF CORNER EVIDENCE FOUND:**

Found a 16" diam. White Fir bears South 60 1/2° West, a dist. of 9.60 ft., alive and vigorous with scribes visible on opened blaze.

Monument position falls in a mudslide area, corner not found.


**DESCRIPTION OF MONUMENT AND ACCESSORIES I ESTABLISHED TO MONUMENT THE ORIGINAL LOCATION OF THIS CORNER:**

At record bearing and distance from the existing bearing tree and confirmed by ties to the monuments to the Center-North 1/16th and the Center-East 1/16th corners, I set a 5/8"x30" iron pin, 29" in the ground, with a 2 1/2" aluminum cap marked as shown below from which:

**NEW BEARING OBJECTS:**

An 18" diam. Blue Spruce bears North 4° West, a dist. of 3.75 feet, marked NE 1/16 S2 BT.

Set steel fencepost 0.3 ft West.

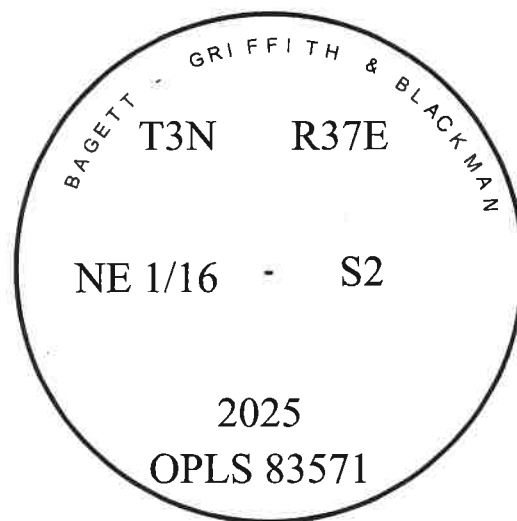

I hereby certify that the corner was monumented on June 30, 2025

Witness: Kyle Tucker, Adam Gordon



Renewal Date: June 30, 2027

I used a steel tape and compass in the establishment of the new accessories from the center of the monument. 14° East was used for declination to a brass washer marked "OPLS 83571" tacked in the "BT" face of the tree. Distances are measured to a 60D spike driven in the right center at the base of the tree.

B-20

**RECEIVED BY**

Umatilla County Surveyor

Date: 8/21/25

Rec'd By: CT

No.: 25-069-R