

CERTIFIED RECORD OF LAND CORNER MONUMENTATION

HISTORY OF ORIGINAL CORNER ESTABLISHED:

Corner established in Survey Number 86-86, by Victor M. McLind. Umatilla County Monumentation record states:


Set 2"x30" Aluminum Pipe with 2 1/2" Al. Cap, marked as shown above, 24" in ground, from which:

A Fir, 12" diam., scribed "C 1/4 S2 BT" bears N 20 1/2°W, 21.7 ft.

A Spruce, 16" diam., scribed "C 1/4 S2 BT" bears N69 1/2°E, 66.2 ft.

Set a steel post 3' south of corner, with sign 54-4. Painted a red bands around both BT's and attached sign 54-3 above blaze and sign 54-4 to back of trees.

T 3 N R 37 C -19

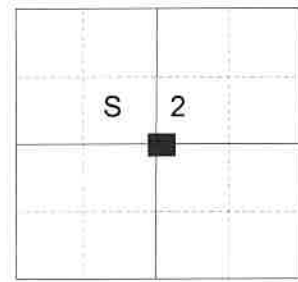

DESCRIPTION OF CORNER EVIDENCE FOUND:

Found a 2 1/2" Aluminum Pipe, 4" above ground, with a 2 1/2" Aluminum Cap marked as shown below, from which:
An 18" diam. Spruce bears North 69° East, a distance of 66.20 ft., Dead and standing 4 ft. tall with scribes visible on decayed remnant of partially healed blaze.
An 18" diam. Douglas Fir bears North 20° West, a distance of 21.70 ft., alive and vigorous with healed blaze.

DESCRIPTION OF MONUMENT AND ACCESSORIES I ESTABLISHED TO PERPETUATE THE ORIGINAL LOCATION OF THIS CORNER:


From the 2 1/2" Aluminum Pipe:

NEW BEARING OBJECTS:

A 4" diam. Western Larch bears North 19° East, a distance of 4.10 feet, marked C 1/4 S2 BT.
A 5" diam. White Fir bears South 23° East, a distance of 9.58 feet, marked C 1/4 S2 BT.
A 5" diam. fir bears South 69° West, a distance of 8.85 feet, marked C 1/4 S2 BT. ◀

I hereby certify that the corner was perpetuated on June 26, 2025

Witness: Kyle Tucker, Adam Gordon

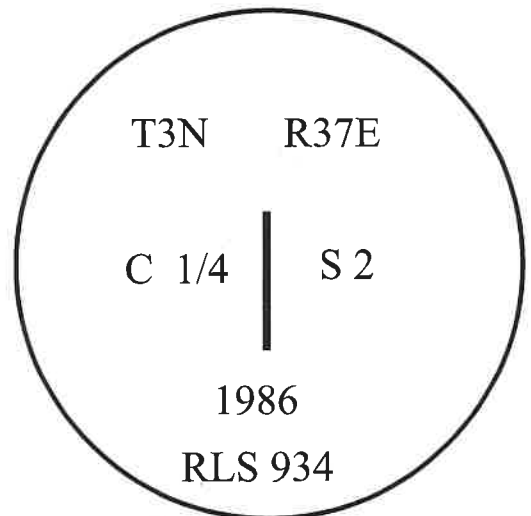

REGISTERED
PROFESSIONAL
LAND SURVEYOR

OREGON
June 2, 2010
JEFFREY S. HSU
83571

Renewal Date: June 30, 2027

I used a steel tape and compass in the establishment of the new accessories from the center of the monument. 14° East was used for declination to a brass washer marked "OPLS 83571" tacked in the "BT" face of the tree. Distances are measured to a 60D spike driven in the right center at the base of the tree.

RECEIVED BY
Umatilla County Surveyor
Date: 8/21/25
Rec'd By: CT
No.: 25-070-R