

CERTIFIED RECORD OF LAND CORNER MONUMENTATION

HISTORY OF ORIGINAL CORNER ESTABLISHED:


Corner established in Survey Number 86-86, by Victor M. McLind. Umatilla County Monumentation record states:

Set 2"x30" Aluminum Pipe with 2 1/2" Al. Cap, marked as shown above, 26" in ground, from which:

A 15" Fir, scribed "SE 1/16 S2 BT" bears N37 1/4°E, 11.5 Ft.
A 19" Fir, scribed "SE 1/16 S2 BT" bears N72 1/2°W, 5.4 Ft.

Set a steel post 3' south of corner, with sign 54-4. Painted a red band around both BT's and attached sign 54-3 above blaze and sign 54-4 to back of trees.

T 3 N R 37 E D-20

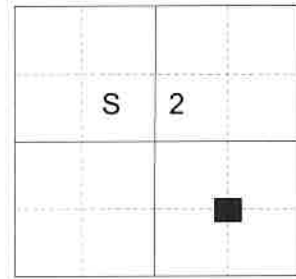

DESCRIPTION OF CORNER EVIDENCE FOUND:

Found a 2 1/2" Aluminum Pipe with 2 1/2" Aluminum Cap, 1" below ground, from which:
A 19" diam. Douglas Fir bears North 37° East, a dist. of 11.50 ft., Alive and vigorous with healed blaze.
A 19" diam. White Fir bears North 72° West, a dist. of 5.40 ft., dead and down with scribes visible on partially healed blaze.

DESCRIPTION OF MONUMENT AND ACCESSORIES I ESTABLISHED TO PERPETUATE THE ORIGINAL LOCATION OF THIS CORNER:

From the 2 1/2" Aluminum Pipe:


NEW BEARING OBJECTS:

A 16" diam. White Fir bears South 76° East, a dist. of 15.55 feet, marked SE 1/16 S2 BT.

Reset found steel fencepost 2 ft East with tag.

I hereby certify that the corner was perpetuated on June 26, 2025

Witness: Kyle Tucker, Adam Gordon

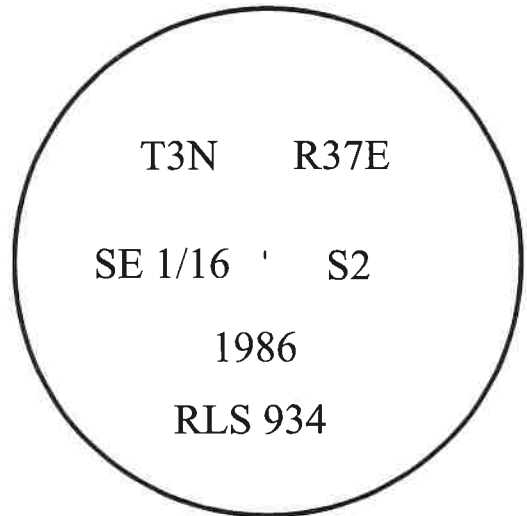

REGISTERED
PROFESSIONAL
LAND SURVEYOR

[Signature]
OREGON
June 2, 2010
JEFFREY S. HSU
83571

Renewal Date: June 30, 2027

I used a steel tape and compass in the establishment of the new accessories from the center of the monument. 14° East was used for declination to a brass washer marked "OPLS 83571" tacked in the "BT" face of the tree. Distances are measured to a 60D spike driven in the right center at the base of the tree.

D-20

RECEIVED BY
Umatilla County Surveyor
Date: 8/21/25
Rec'd By: CT
No.: 25-071-R