

USDA-FOREST SERVICE

Index File No. E-21

CORNER RECORD (SEARCH)

(Ref. FSM 7151.4)

Tract or Survey No. _____ Cor. No. _____

T 3N R. 37E

R.D. Walla Walla County Umatilla

Merid. Willamette

N.F. Umatilla State Oregon

CORNER DIAGRAM



T3N R37E
 S2 | S1
 S11 | S12
 RPE 2808
 1976

DESCRIBE CORNER MONUMENT FOUND

Found 2 1/2" brass cap on a 2 1/2" galv. iron pipe projecting 2" from a mound of stone.

DESCRIBE BEARING TREES OR OTHER OFFICIAL ACCESSORIES FOUND

A 22" white fir bears N 15° E, 44.8' with previously opened blaze. (Original BT). A 34" white fir bears S 46° E, 15.8' with healed blaze. (Original BT). A 28" dying white fir bears S 45° W, 19.9' with healed blaze. A 30" white fir bears N 32° W, 22.4' with healed blaze. (Original BT). **NOTE: THE WHITE FIR BEARING S45°W IS AN ORIGINAL BEARING TREE.**

PHOTO IDENTIFICATION DATA

Photo No. _____
 Filed At. _____
 Object Ident. _____
 Ident. By _____
 Signature _____

PLANE COORDINATE POSITION DATA

State _____ Zone _____
 X _____
 Y _____
 Estab. By _____
 Agency _____

DESCRIBE CORNER LOCATION RELATIVE TO NEAR-BY FEATURES, ALSO HOW TO REACH CORNER

Corner is located on a steep east slope about 250' west of Coyote Creek.

Signature Willie R. Wells

Title PLS

Division _____

Headquarters Pendleton, OR

Date 9/17/91

FS-7100-52 (3/66)

CORNER RECORD (PERPETUATION)

MONUMENT: DESCRIBE NEW MONUMENT SET, OR WORK DONE TO PRESERVE EXISTING MONUMENT

Maintained existing corner monument by cleaning up around it. There is a steel fence post 3' west of corner with sign 54-2 and 54-9 attached.

ACCESSORIES : DESCRIBE NEW BT^s WITNESS OBJECTS ETC. ESTABLISHED, OR WORK DONE TO PRESERVE EXISTING EVIDENCE

Marked 2 new bearing trees:

A 11" white fir bears N 27° E, 51.9' scribed T3N R37E S1 BT.

A 10" white fir bears S 01½° W, 30.7' scribed T3N R37E S11 BT.

New bearing trees have a brass washer stamped PLS 1106 nailed to face of blaze. Attached sign 54-3 and 54-9 and painted face of blaze and a 6" red band around each bearing tree.

Work Done By W.R. Wells Title PLS Date 9/17/91 State Registration No. 1106
or Agency

Certified Cor. Record Prepared ? Yes No Filed At Jmatilla Co. Surveyor's Off. Date 12/31

REMARKS

Note: There is a blazed 10" white fir N 35° E 30.6' from corner with no scribes. (a yellow jacket nest was encountered at the base of tree).

Index File No. E-21 T. 3N R. 37E M. Will Tract or Surv. No.

GPO: 1986 O-439-095

Cor.

USDA-FOREST SERVICE

Index
File No. E-21

CORNER RECORD (SEARCH)

(Ref. FSM 7151.4)

Tract or
Survey No. _____ Cor. No. _____


T 3N R. 37E

R.D. WALLA WALLA County UMATILLA

Merid. Will.

N.F. UMATILLA State OR

CORNER DIAGRAM

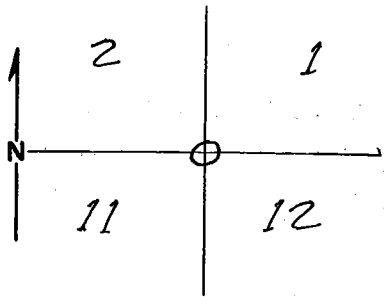

DESCRIBE CORNER MONUMENT FOUND

2" I. PIPE WITH 2 1/2" BR. CAP, MKD. AS SHOWN →
4" ABOVE GROUND IN MOUND OF STONE.

T3N R37E
52 | 51
511 | 512
RPE 2808
1976 2

DESCRIBE BEARING TREES OR OTHER OFFICIAL ACCESSORIES FOUND

- OBT, 30" FIR, HEALED BLAZE, BEARS S46°E, 16.8 FT.
- OBT, 29" FIR, HEALED BLAZE, BEARS S40°W, 9.9 FT.
- OBT, 34" FIR, HEALED BLAZE, BEARS N35°W, 22.4 FT.
- OBT, 22" FIR, BLAZE PARTLY CHOPPED OPEN, SCRIBES "51" VISIBLE, BEARS N14°E, 46.2 FT.

PHOTO IDENTIFICATION DATA

Photo No. _____
Filed At. _____
Object Ident. _____
Ident. By _____

Signature

PLANE COORDINATE POSITION DATA

State _____ Zone _____
X _____
Y _____
Estab. By _____
Agency

DESCRIBE CORNER LOCATION RELATIVE TO NEAR-BY FEATURES, ALSO HOW TO REACH CORNER

COR. LIGS ON VERY STEEP E. SLOPE, IN A GROVE OF LARGE FIRS.

Signature

Victor M. Ford

Title

LS

Division

Headquarters

Date

6-25-86

FS-7100-52 (3/68)

CORNER RECORD (PERPETUATION)

MONUMENT: DESCRIBE NEW MONUMENT SET, OR WORK DONE TO PRESERVE EXISTING MONUMENT

9

ACCESSORIES : DESCRIBE NEW BT'S WITNESS OBJECTS ETC. ESTABLISHED, OR WORK DONE TO PRESERVE EXISTING EVIDENCE

SET STEEL POST ABOUT 3 FT. W. OF CORNER, WITH SIGNS 54-2 AND 54-9
PAINTED A RED BAND AROUND ALL BT'S.
REPLACED 1 B.T. SIGN
NAILED SIGN 54-4 TO BACK OF ALL BT'S.

10

Work Done By V. MC LIND Title LS Date _____ State Registration No. 934
or Agency _____

Certified Cor. Record Prepared ? Yes No _____ Filed At: _____ Date _____

11


REMARKS

12

Index File No. E-21 T. 3N R. 37E M. WILL. Tract or Surv. No. _____ Cor. _____

13

Index _____
 File No. E 21 CORNER RECORD (SEARCH) (Ref. FSM 7151.4) Tract or _____ Cor. _____
 T 3 N R. 37 E R.D. Pendleton County Umatilla Survey No. _____ No. E 21
 Merid. Willamette N.F. Umatilla State Oregon

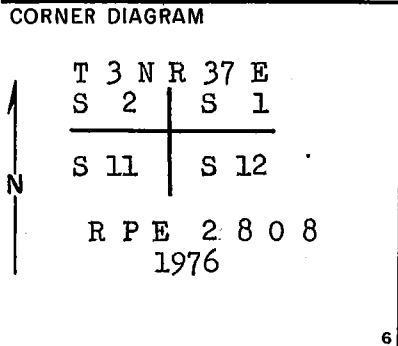

DESCRIBE CORNER MONUMENT FOUND

Found a basalt stone 16" x 14" x 4" in place on NE face of steep hillside (65% slope)

2

DESCRIBE BEARING TREES OR OTHER OFFICIAL ACCESSORIES FOUND

A 22" fir bears N 15° E., 46.2 ft. (70 lks) with previously opened blaze with visible scribing S-1 inside 4" overgrowth.
 A 34" fir bears S 46° E., 15.8 ft. (24 lks) with healed blaze.
 A 28" fir bears S 38° W., 9.9 ft. (15 lks) with healed blaze.
 A 30" fir bears N 40° W., 22.4 ft. (34 lks) with healed blaze.

3

PHOTO IDENTIFICATION DATA

Photo No. _____
 Filed At. _____
 Object Ident. _____
 Ident. By _____
 Signature _____

7

DESCRIBE CORNER LOCATION RELATIVE TO NEAR-BY FEATURES, ALSO HOW TO REACH CORNER

Westerly from west edge of Tollgate 3.5 miles to road south between metal snow fence- Thence southerly 1.2 miles to creek crossing and road forks- Thence on right fork to end of road at west fork Coyote Creek- Thence follow creek southerly to cruiser tag on right edge of creek.
 Corner is 400 feet west.

4

PLANE COORDINATE POSITION DATA

State _____ Zone _____
 X _____
 Y _____
 Estab. By _____
 Agency _____
 Signature _____

8

James H. Sawyer

Title RPE 2808 Division _____ Headquarters _____ Date 7/29/76 7100-52 (3/68)

5

CORNER RECORD (PERPETUATION)

MONUMENT : DESCRIBE NEW MONUMENT SET, OR WORK DONE TO PRESERVE EXISTING MONUMENT

Set a 2 1/2" brass cap on 2" iron pipe 31" long 6" above ground in earth and rock mound with 6' steel fence post 3' west with signs 54-4 and 54-2 attached.

9

ACCESSORIES : DESCRIBE NEW BT'S WITNESS OBJECTS ETC. ESTABLISHED, OR WORK DONE TO PRESERVE EXISTING EVIDENCE

All original BT's are in good condition.
Painted BT's with red paint and attached signs 54-3 to each.

10

Work Done By. James D. Hanley Title Engineer Date 7/29/76 State Registration No. ORPE 2808
or Agency

Certified Cor. Record Prepared ? Yes Filed At: Pendleton, Oregon Date 8/ /76

11

REMARKS

Buried stone alongside brass cap monument.

12