

USDA-FOREST SERVICE

Index

File No. E-23

CORNER RECORD (SEARCH)

(Ref. FSM 7151.4)

Tract or

Survey No. _____

Cor.

No. _____

T 3N R. 37E

R.D. Walla Walla

County

Umatilla

Merid. Willamette

N.F. Umatilla

State

Oregon

CORNER DIAGRAM

T3N R37E

SS1

$\frac{1}{4}$

S12

RPE 2808

1976

PHOTO IDENTIFICATION DATA

Photo No. _____

Filed At. _____

Object Ident. _____

Ident. By _____

Signature

PLANE COORDINATE POSITION DATA

State _____ Zone _____

X _____

Y _____

Estab. By _____

Agency

DESCRIBE CORNER MONUMENT FOUND

Found a $2\frac{1}{2}$ " brass cap on a $2\frac{1}{2}$ " galv. iron pipe protruding 4" out of the ground.

DESCRIBE BEARING TREES OR OTHER OFFICIAL ACCESSORIES FOUND

A 30" ponderosa pine stump bears N 80° E, 16.5' with scribes visible on part of blaze. (Original BT).

A 12" western larch bears N 36° E, 54.0' with healed double blaze. (RPE 2808 BT).

A 13" ponderosa pine bears S 55° E, 54.0' with healed double blaze. (RPE 2808 BT).

DESCRIBE CORNER LOCATION RELATIVE TO NEAR-BY FEATURES, ALSO HOW TO REACH CORNER

Corner is located 200' west of a north-south road. There is a location poster on a wood post on the road.

Signature
Walter R. Wells

Title
PLS

Division

Headquarters

Pendleton, OR

Date

9/13/91

FS-7100-52 (3/88)

CORNER RECORD (PERPETUATION)

MONUMENT: DESCRIBE NEW MONUMENT SET, OR WORK DONE TO PRESERVE EXISTING MONUMENT

Maintained existing monument by remounding with earth and stone. Set steel fence post east of corner and attached signs 54-2 and 54-9.

ACCESSORIES : DESCRIBE NEW BT^s WITNESS OBJECTS ETC. ESTABLISHED, OR WORK DONE TO PRESERVE EXISTING EVIDENCE

Marked 2 new bearing trees:

A 11" western larch bears S 34° E, 19.5' scribed 1/4 S12 BT.


A 11" western larch bears N 10 1/2° W, 53.1' scribed 1/4 S1 BT.

New bearing trees have a brass washer stamped PLS 1106 nailed to face of blaze
Attached sign 54-3 and 54-9 and painted face of blaze and a 6" red band
around all bearing trees.

Work Done By W.R. Wells Title PLS Date 9/13/9 State Registration No. 1106
or Agency
Certified Cor. Record Prepared? Yes No Filed At: Umatilla Co. Surveyor OFF Date 12/31

REMARKS

Index _____
 File No. E 23 **CORNER RECORD (SEARCH)** Tract or _____ Cor. _____
 (Ref. FSM 7151.4) Survey No. _____ No. E 23
 T 3 N R. 37 E R.D. Pendleton County Umatilla
 Merid. Willamette N.F. Umatilla State Oregon

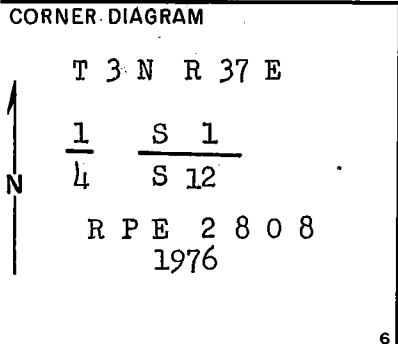

DESCRIBE CORNER MONUMENT FOUND

NONE

DESCRIBE BEARING TREES OR OTHER OFFICIAL ACCESSORIES FOUND

A fir stump 32" diam. (sawed at 24") bears N 80° E., 16.5 ft. (25 lks) with scribes B T visible.

A depression in the ground indicating old stump hole bears S 35° E., 7.26 ft. (11 lks)

PHOTO IDENTIFICATION DATA

Photo No. _____

Filed At. _____

Object Ident. _____

Ident. By _____

Signature _____

DESCRIBE CORNER LOCATION RELATIVE TO NEAR-BY FEATURES, ALSO HOW TO REACH CORNER

Corner is 200 ft. west of "P" station 89+00.
 Placed location tag on 4" pine on right side of road.

PLANE COORDINATE POSITION DATA

State _____ Zone _____

X _____

Y _____

Estab. By _____

Agency _____

Signature James D. Hawley

Title _____ Division _____ Headquarters _____ Date 7/29/76

RPE 2808 7100-52 (3/68)

CORNER RECORD (PERPETUATION)

MONUMENT: DESCRIBE NEW MONUMENT SET, OR WORK DONE TO PRESERVE EXISTING MONUMENT

Set a 2 1/2" brass cap on a 2" iron pipe 31" long 6" above the ground with a 6' steel fence post 3' east with signs 54-4 and 54-2 attached.

9

ACCESSORIES : DESCRIBE NEW BT'S WITNESS OBJECTS ETC. ESTABLISHED, OR WORK DONE TO PRESERVE EXISTING EVIDENCE

A pine 7" diam. bears S 55° E., 54.0 ft. dist marked 1/4 S 12 BT
A larch 6" diam. bears N 36° E., 54.0 ft. dist marked 1/4 S 1 BT

Each BT sign 54-3 attached 6" below band of red paint and has a brass washer marked RPE 2808 nailed flush with BT blaze.

10

Work Done By James D. Hanley Title Engineer Date 7/29/76 State Registration No. ORPE 2808
or Agency

Certified Cor. Record Prepared ? Yes No Filed At: Pendleton, Oregon Date 8/ /76

11

REMARKS

Corner is on level ground 300 feet east of tall timber in area of dense underbrush 3' to 5' high and heavily populated with 4" to 6" pine recently thinned.

Area was heavily logged many years ago for 30" to 40" fir.

12