

Index
File No. X-25

CORNER RECORD (SEARCH)

(Ref. FSM 7151.4)

Tract or
Survey No. _____ Cor.
No. _____


T 3N R. 37E

R.D. WALLA WALLA County UMATILLA

Merid. WILLAMETTE

N.F. UMATILLA State OREGON

CORNER DIAGRAM

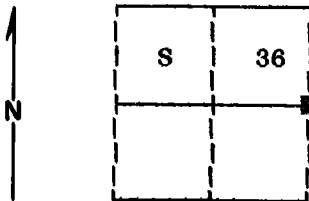

DESCRIBE CORNER MONUMENT FOUND

Found no evidence of the original corner monument.

DESCRIBE BEARING TREES OR OTHER OFFICIAL ACCESSORIES FOUND

Found no evidence of the original accessories.

PHOTO IDENTIFICATION DATA

Photo No. _____

Filed At. _____

Object Ident. _____

Ident. By _____

Signature

PLANE COORDINATE POSITION DATA

State _____ Zone _____

X _____

Y _____

Estab. By _____

Agency

Signature

DESCRIBE CORNER LOCATION RELATIVE TO NEAR-BY FEATURES, ALSO HOW TO REACH CORNER

Corner falls approximately 300 feet North of the end of the 3150-035 road, at the South edge of a clearcut.

Title

Division

Headquarters

Date

FS-7100-52 (3/68)

CORNER RECORD (PERPETUATION)

MONUMENT: DESCRIBE NEW MONUMENT SET, OR WORK DONE TO PRESERVE EXISTING MONUMENT

Set a 2½"x30" aluminum pipe with aluminum cap marked as shown:
 Pipe is set 30 inches in the ground.

T3N
 R37E R38E
 ¼ S36
 1991
 OPLS 644

9

ACCESSORIES : DESCRIBE NEW BT'S WITNESS OBJECTS ETC. ESTABLISHED, OR WORK DONE TO PRESERVE EXISTING EVIDENCE

New BT's:

- A 8 inch diam. White Fir bears S67°E, 20.44 feet marked X X BT
- A 9 inch diam. White Fir bears S31°E, 15.63 feet marked X BT
- A 12 inch diam. White Fir bears S59°W, 9.21 feet marked ¼ S36 BT
- A 10 inch diam. White Fir bears N42°W, 21.14 feet marked 1/4 X BT

Attached Bearing Tree and Land Survey Monument signs to the BTs

Set a steel fencepost approximately 5 feet South with Land Survey Monument sign attached.

10

Work Done By	D.I. Griffith	Title	Surveyor	Date	10-10-92	State Registration No.	OPLS 644
				or Agency			
Certified Cor. Record Prepared ?	Yes <input type="checkbox"/> No <input checked="" type="checkbox"/>	Filed At:	Umatilla Co. Surveyor Off.		Date	10-92	

11

REMARKS

Witness: Jim Bennett

12

Index File No.	T.	R.	M.	Tract or Surv. No.	Cor.
----------------	----	----	----	--------------------	------

13

USDA-FOREST SERVICE

Index

File No. X-25

CORNER RECORD (SEARCH)

Tract or

Cor.

Survey No.

No.

T 3N

R. 37E

R.D.

Umatilla (Ref. FSM 7151.4)

County Umatilla

Merid. Will


N.F.

Umatilla

State Oregon

CORNER DIAGRAM

T3N R37E

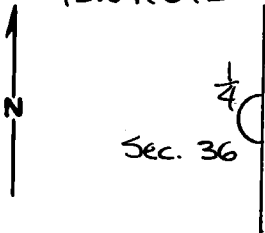

DESCRIBE CORNER MONUMENT FOUND

None found

DESCRIBE BEARING TREES OR OTHER OFFICIAL ACCESSORIES FOUND

None found. Area has been heavily logged over.

PHOTO IDENTIFICATION DATA

Photo No. _____

Filed At. _____

Object Ident. _____

Ident. By _____

Signature

PLANE COORDINATE POSITION DATA

State _____ Zone _____

X _____

Y _____

Estab. By _____

Agency

DESCRIBE CORNER LOCATION RELATIVE TO NEAR-BY FEATURES, ALSO HOW TO REACH CORNER

I put a location poster at the approx. corner point as determined with a hand compass & hip chain.

Signature

Title

Division

Headquarters

Date

7100-52-(3/68)

Dennis L. Gaylord

PLS 1636

S.O.

10-3-84

CORNER RECORD (PERPETUATION)

MONUMENT: DESCRIBE NEW MONUMENT SET, OR WORK DONE TO PRESERVE EXISTING MONUMENT

ACCESSORIES : DESCRIBE NEW BT'S WITNESS OBJECTS ETC. ESTABLISHED, OR WORK DONE TO PRESERVE EXISTING EVIDENCE

Work Done By _____ Title _____ Date _____ State Registration No. _____
or Agency _____

Certified Cor. Record Prepared ? Yes No Filed At: _____ Date _____

REMARKS

Index File No. T. R. M. Tract or Surv. No. Cor.