

**CERTIFIED RECORD OF LAND CORNER MONUMENTATION**

**History of original corner establishment:**

Original corner established by George S. Pershin, under GLO Group No. 304, dated September 19, 1878.

**Record states:**

Set Basalt stone 16x8x7 on SW hill.

**From which:**

- Fir 8 inch diam brs N 10° E, 60 lks dist
- Fir 20 inch diam brs S 24° E, 99 lks dist
- Fir 36 inch diam brs S 38° W, 66 lks dist
- Fir 18 inch diam brs N 68° W, 78 lks dist

Corner perpetuated by William E. Campbell under GLO Con. No. 718, dated May 1, 1900.

**Record states:**

In retracing the S Bdy of section 35, I discover it to be defective. Set Basalt sone 15x15x4 ins. in the ground for corners 35 and 36 marked with 1 notch on E. and 5 notches on W.

**From which:**

- Fir 10 inch diam brs N 14° E, 52 lks dist marked T3N R37E S36 BT
- Fir 18 inch diam brs N 68° W, 78 lks dist marked T3S R37E S35 BT

Corner remonumented by Duane I. Griffith, LS 644, as described by Surveyor's Report for Wilderness Boundary Survey under Contract No. 53-04R3-89-51, dated June 26, 1992.



**Record states:**

In place of found stone, I set a 2 1/2" x 30" aluminum pipe with aluminum cap marked as shown, 26 inches in the ground.

**From which**

- A 15 inch Douglas fir, bears N 26° E, 45.94 feet, marked T3N R37E S36 BT.
- A 5/8"x18" iron pin with plastic cap, marked BGA SURVEY MARKER, bears North, 4.71 ft. dist.
- A 5/8"x18" iron pin with plastic cap, marked BGA SURVEY MARKER, bears East, 7.60 ft. dist.
- A 14 inch Douglas fir, bears N 68° W, 63.90 feet, marked T3N R37E S35 BT.

Z-21

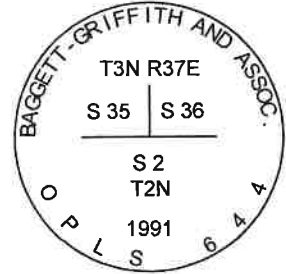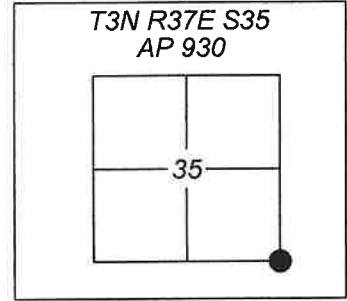

**Description of corner evidence found:**

Found a 2 1/2 inch aluminum cap, mkd. as shown, on a 2 1/2 inch aluminum pipe, buried 4 inches.

**From which:**

- A 5/8 x 18 inch iron rod with yellow plastic cap, mkd. BGA SURVEY MARKER, out of the ground, bears North, 4.71 ft. dist.
- A 24 inch Douglas fir, alive and healthy, healed double blaze, bears N 26° E, 45.94 ft. dist.
- A 5/8 x 18 inch iron rod with yellow plastic cap, mkd. BGA SURVEY MARKER, bears East, 7.60 ft. dist.
- A 23 inch Douglas fir, alive and healthy, healed double blaze, bears N 68° W, 63.90 ft. dist.

**Description of monument and accessories I established to perpetuate original location of this corner:**

**New Accessories:**

- (RM 1) A 5/8 x 30 inch iron rod with light blue plastic cap mkd: WALLOWA ASSOCIATES, bears N 1°38' E, 16.2 ft. dist.
- (RM 4) A 5/8 x 30 inch iron rod with light blue plastic cap mkd: WALLOWA ASSOCIATES, above ground 3 inches with rock collar, bears N 76°16' W, 8.63 ft. dist.

Posted and marked wilderness boundary N 89°33'53" W from corner with Wilderness Boundary (27-6A) signs, and a Land Survey Monument (54-9) sign on nearby post.

**NAD 83 Geodetic Position**

Lat. 45°41'14.59" N  
Long. 118°08'57.74" W

Established by: Trimble RTK

I hereby certify that the corner is monumented and accessories taken as described, using dual frequency carrier-phase GNSS receivers.

All bearing trees are painted with 6 inch red bands, and have Bearing Tree (54-3) and Land Survey Monument (54-9) signs attached.

Witnesses: Kristina Powell, Dewey Bruner and David Quittschreiber  
Date: 7-11-19

REGISTERED  
PROFESSIONAL  
LAND SURVEYOR

*Kristina Powell*

OREGON  
MAY 9, 2017  
**KRISTINA POWELL**  
91201

EXPIRES 12-31-20

Office of \_\_\_\_\_ County Surveyor \_\_\_\_\_ County of Umatilla  
State of Oregon, I hereby certify that the within instrument was filed in this office  
for record on the 10<sup>th</sup> day of December, 2019.  
*[Signature]* by \_\_\_\_\_  
(COUNTY OFFICIAL) (DEPUTY)