

Form 874-9

U. S. DEPARTMENT OF AGRICULTURE
FOREST SERVICE

AK

Winnalilla NATIONAL FOREST

CORNERS OF THE PUBLIC SURVEY

T. 3 N. R. 38 E. W. Mer.

Section Corner common to Sections
5, and 6

DESCRIPTION OF CORNER

Corner consists of a stake

Dimension above ground 4 inches.
Sketch grooves, letters, figures, or notches, on proper face or edge.

CARDINAL POSITION

	CC	25	CC
	SL	SN	S
		SR	S
		38	S
N	W	S	E

DIAGONAL POSITION

NW	SW	SE	NE

Mound of _____ is located _____

Pits are located _____

Sketch markings of Bearing Trees (or Rocks) in proper box and fill blanks below, giving bearings from Corner to Trees and Distances in Links.

Tree from up mostly

Species alpine sif art
 Diameter 8 9
 Bearing SE SW
 Distance 1/2 1/2

Do you believe this to be a genuine Land Office Corner? _____

If not, why? yes _____


L. L. Keithley
Signature.

Aug 18-21
Date.

T. 37 R. 38 E. Mer.

8-3027

(Make sketch of topography near Corner.)

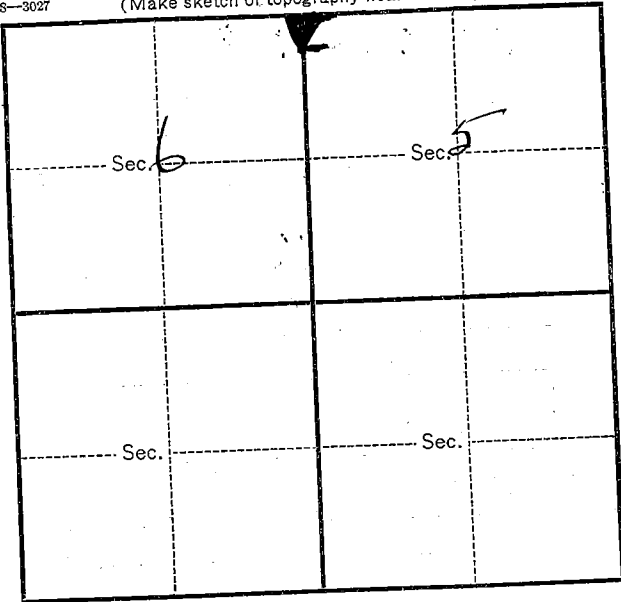

Metal Location Poster is on a _____
tree _____ inches diameter, on the _____
side of _____
from which this Corner bears _____
_____ chains distant.

Give any further facts which will aid in finding this
Corner again.

Hill slopes to East.
gentle slopes - 1145.
corner to Sec. 37 Twp 4 N
R 38 E. 6 rods south.

USDA-FOREST SERVICE

Index File No. A-5
 T 3N R. 38E
 Merid. WILLAMETTE

CORNER RECORD (SEARCH)


(Ref. FSM 7151.4)

Tract or Survey No. _____ Cor. No. _____

R.D. WALLA WALLA County UMATILLA
 N.F. UMATILLA State OREGON

CORNER DIAGRAM

DESCRIBE CORNER MONUMENT FOUND

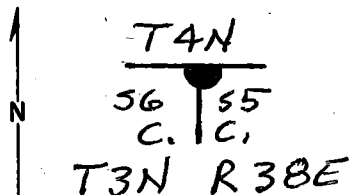

2" BRASS CAPPED IRON PIPE - ~~BEAT~~
 1939. GLO

DESCRIBE BEARING TREES OR OTHER OFFICIAL ACCESSORIES FOUND

ORIG. 7" SPRUCE IS A SAWN STUMP 3 FEET HIGH WITH DOUBLE HEALED BLAZES. BEARS 575°E, 26 LINKS,
 ORIG. 8" FIR IS A BROKEN & SAWN SNAG 6 FEET HIGH, WITH VISIBLE SCRIBES. BEARS

PHOTO IDENTIFICATION DATA

Photo No. _____
 Filed At. _____
 Object Ident. _____
 Ident. By _____
 Signature _____

DESCRIBE CORNER LOCATION RELATIVE TO NEAR-BY FEATURES, ALSO HOW TO REACH CORNER

529°W, 33 LINKS,
 AT THE 1899 SUPERCEDED CORNER, WHICH IS 93 LINKS WEST, I FOUND THE ORIG. 12" FIR IS A SAWN STUMP WITH FRAGMENTARY SCRIBES VISIBLE ON A PARTLY HEALED LOWER BLAZE. CONTINUED ON BACK.

PLANE COORDINATE POSITION DATA

State _____ Zone _____
 X _____
 Y _____
 Estab. By _____
 Agency _____

Signature

Title

Division

Headquarters

Date

FS-7100-52 (3/68)

Dennis L. Layford PLS 1636 9/19/1997

CORNER RECORD (PERPETUATION)

MONUMENT: DESCRIBE NEW MONUMENT SET, OR WORK DONE TO PRESERVE EXISTING MONUMENT

ACCESSORIES : DESCRIBE NEW BT'S WITNESS OBJECTS ETC. ESTABLISHED, OR WORK DONE TO PRESERVE EXISTING EVIDENCE

I PUT BT SIGNS ON THE TWO STUMPS REFERENCING THE BRASS CAPPED MONUMENT.

Work Done By _____ Title _____ Date _____ State Registration No. or Agency _____

Certified Cor. Record Prepared ? Yes No Filed At: _____ Date _____

REMARKS
SUPERCEDED CORNER, CONTINUED;
THE ORIG. 5" FIR IS A 4' LONG SAWN STUMP LYING ON THE GROUND. I OPEN UPPER HEALED BLAZE & FIND FRAGMENTARY SCRIBES.

Index File No. T. R. M. Tract or Surv. No. Cor.

A-5 T3N R38E