

USDA-FOREST SERVICE

Index
File No. J-5
T 3N R. 3BE
Merid. WILLAMETTE


CORNER RECORD (SEARCH)

(Ref. FSM 7151.4)

Tract or
Survey No. _____
R.D. WALLA WALLA County UMATILLA
N.F. UMATILLA State OREGON

Cor.
No. _____

CORNER DIAGRAM

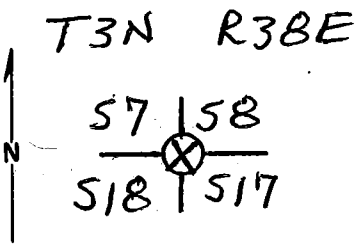

DESCRIBE CORNER MONUMENT FOUND

NONE - SEVERAL STONES OF RECORD SIZE IN AREA, BUT NONE ARE MARKED.

DESCRIBE BEARING TREES OR OTHER OFFICIAL ACCESSORIES FOUND

NONE SET - THE 1899 SUPERCEDED CORNER WAS RECOVERED & BEARS (RECORD) NORTH, 310.2 FEET.

PHOTO IDENTIFICATION DATA

Photo No. _____
Filed At. _____
Object Ident. _____
Ident. By _____
Signature _____

PLANE COORDINATE POSITION DATA

State _____ Zone _____
X _____
Y _____
Estab. By _____
Agency _____

DESCRIBE CORNER LOCATION RELATIVE TO NEAR-BY FEATURES, ALSO HOW TO REACH CORNER

THE 1899 CORNER IS AT WEST END OF A SMALL, ROCKY OPENING LOCATED 100 FEET SOUTH OF TRAIL HEAD PARKING AREA. SEE BACK FOR 1899 CORNER RECOVERY NOTES.

Signature

Title

Division

Headquarters

Date

FS-7100-52 (3/68)

Wernis L. Daylord

PLS 1636

9/23/1997

CORNER RECORD (PERPETUATION)

MONUMENT : DESCRIBE NEW MONUMENT SET, OR WORK DONE TO PRESERVE EXISTING MONUMENT

ACCESSORIES : DESCRIBE NEW BT'S WITNESS OBJECTS ETC. ESTABLISHED, OR WORK DONE TO PRESERVE EXISTING EVIDENCE

Work Done By _____ Title _____ Date _____ State Registration No. _____
or Agency _____

Certified Cor. Record Prepared ? Yes No Filed At: _____ Date _____

REMARKS

(1899 RECOVERY)
 CORNER AREA DISTURBED BY BULLDOZER.
 ORIG. 5" FIR IS NOW A 24" FIR SNAG 10 FEET HIGH. HAS DOUBLE
 HEALED BLAZES. I OPEN TO VERY FRAGMENTARY SCRIBES. BEARS N 23 3/4° E
 115 LINKS, ORIG. 16" FIR IS LIVE 30" FIR WITH HEALED BLAZES. BEARS
 S 25 1/2° E, 184 LINKS, ORIG. 8" FIR IS DOWN & DELAYED. I OPEN & FIND
 SCRIBES "518" ONLY ON UPPER & "BT" ON LOWER BLAZES, BEARS S 22° W, 154 LKS

Index File No. **J-5** T. **T3N** R. **R38E** M. **ORIG. 5" FIR IS DOWN & DELAYED - ROOT** Tract or Surv. No. **HOLE BEARS N 25° W, 112 FEET.** Cor. **13**