

USDA-FOREST SERVICE

Index File No. A-25

CORNER RECORD (SEARCH)
(Ref. FSM 7151.4)

Tract or Survey No. _____ Cor. No. _____


T ~~3~~ 24 R. 38E

R.D. _____ County UNION

Merid. WILLAMETTE


N.F. UMATILLA State OREGON

CORNER DIAGRAM

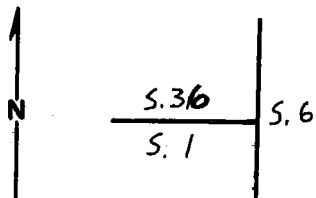

DESCRIBE CORNER MONUMENT FOUND

FOUND A 2 1/2" DIAM. BRASS CAP SET IN A 2" IRON PIPE IN A ROCK MOUND AND STAMPED PER SKETCH.

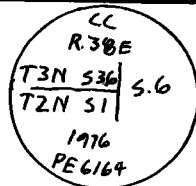

DESCRIBE BEARING TREES OR OTHER OFFICIAL ACCESSORIES FOUND

- ① A 16" D.B.H. WHITE FIR, S.38°W, 40.2', SCRIBED T2N R38E S1 B.T. BRASS WASHER 1 PE 6164
- ② A B.T. STOB, S.32°W, 26.3', SCRIBES R38E, OR16. B.T. (S.27°W, 26.4')
- ③ A 20" D.B.H. WHITE FIR, N.51°E, (S.51°E, 33.4') 34°' SCRIBED T2N R39E S6 BT CORRODED BRASS WASHER

PHOTO IDENTIFICATION DATA

Photo No. _____
 Filed At. _____
 Object Ident. _____
 Ident. By _____
 Signature _____

PLANE COORDINATE POSITION DATA

State _____ Zone _____
 X _____
 Y _____
 Estab. By _____
 Agency _____

DESCRIBE CORNER LOCATION RELATIVE TO NEAR-BY FEATURES, ALSO HOW TO REACH CORNER

FROM THE INTERSECTION OF 1026 1/2 DIVISION IN ELGIN, GO NORTH TO INTERSECTION, 0.5 MILES, GO LT. 0.7 MILES, GO RT. 2.0 MILES, GO LT. 0.6 MILES, GO RT. ON DARR ROAD 4.7 MILES, GO LT. AT MEADOW 2.3 MILES, GO RT. 1 MILE, GO LT. 0.3 MILES, TO FOREST ROAD, GO RT. 0.9 MILES, SEE LOCATION TAG ON BIG FIR, @ TOP OF HILL, CORNER IS 300'± EAST AND 328' SOUTH.

Signature Clayton J. [unclear]

Title LAND SUVEYOR

Division _____

Headquarters _____

Date SEPT 14, 1982

7100-52-(3/68)

CORNER RECORD (PERPETUATION)

MONUMENT: DESCRIBE NEW MONUMENT SET, OR WORK DONE TO PRESERVE EXISTING MONUMENT

ACCESSORIES: DESCRIBE NEW BT'S WITNESS OBJECTS ETC. ESTABLISHED, OR WORK DONE TO PRESERVE EXISTING EVIDENCE

① A 8" D.B.H. WHITE FIR, N. 60° W., 73.2', SCRIBED T3N R38E S36 BT RPLS 1910 BRASS WASHER
BETWEEN B & T

Work Done By C.J. MARTIN Title LAND SURVEYOR Date 9-19-82 State Registration No. or Agency _____

Certified Cor. Record Prepared? Yes No Filed At: _____ Date _____

REMARKS

Index File No. T. 3N R. 38E M. WILLAMETTE Tract or. Surv. No.

Cor. 36/6 13
U.S. G.P.O. 1977-725-576/586

USDA-FOREST SERVICE

Index
File No. Z-25

CORNER RECORD (SEARCH)


(Ref. FSM 7151.4)

Tract or
Survey No. _____ Cor. No. Z-25

T 3 N R. 38 E
Merid. Willamette

R.D. Pend. County _____
N.F. Umatilla State Ore.

CORNER DIAGRAM

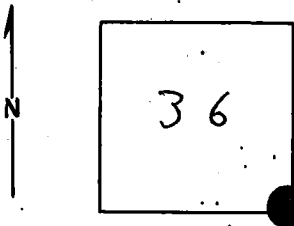

DESCRIBE CORNER MONUMENT FOUND

Brass Cap! 1976 see mon. file.

DESCRIBE BEARING TREES OR OTHER OFFICIAL ACCESSORIES FOUND

PHOTO IDENTIFICATION DATA

Photo No. _____
Filed At. _____
Object Ident. _____
Ident. By _____
Signature

DESCRIBE CORNER LOCATION RELATIVE TO NEAR-BY FEATURES, ALSO HOW TO REACH CORNER

PLANE COORDINATE POSITION DATA

State _____ Zone _____
X _____
Y _____
Estab. By _____
Agency

Signature

Title

Division

Headquarters

Date

7100-52-(3/68)

CORNER RECORD (PERPETUATION)

MONUMENT: DESCRIBE NEW MONUMENT SET, OR WORK DONE TO PRESERVE EXISTING MONUMENT

9

ACCESSORIES : DESCRIBE NEW BT'S WITNESS OBJECTS ETC. ESTABLISHED, OR WORK DONE TO PRESERVE EXISTING EVIDENCE

10

Work Done By _____ Title _____ Date _____ State Registration No. or Agency _____

Certified Cor. Record Prepared ? Yes No Filed At: _____ Date _____

11

REMARKS

12

Index File No. T. R. M. Tract or Surv. No. Cor.

13